

SURVEY & REMONUMENTATION

JAN 22 1998

SECTION

LAND CORNER RECORDATION CERTIFICATE
Filing Requirement of Act 74, Mich. P.A. 1970

For corners in

<u>Gogebic</u> (County)	Located In:	Corner Code #
1. Public Land Survey	T <u>45N</u> R <u>41W</u>	<u>H-5</u>
	T _____ R _____	_____
	T _____ R _____	_____
	T _____ R _____	_____
2. Property Controlling in Section	S _____ T _____ R _____	_____
	S _____ T _____ R _____	_____
3. Miscellaneous Property in Sec.	S _____ T _____ R _____	_____
	S _____ T _____ R _____	_____

Register's Office }
Gogebic County } ss.


Received for record the
22nd day of DECEMBER
A. D. 19 97 at 11:00 o'clock
4 a.m., and recorded in
Liber 6 of CORNELL
on page 290.
Romona Collins Deputy
Register of Deeds

Register of Deeds Stamp & File Number

4. Lot No. _____, Recorded Plat _____
5. Private Claims _____

$\frac{1}{4}$ Corner 10 & 15; T.45 N., R.41 W.

Richard L. Drahn in a field survey on December 13, _____, 19 97, do hereby certify that under requirements of P.A. 74, Michigan P.A. of 1970, the corner points mentioned in lines 1 and 2 above were in conformance with regulations and rules therefore as required in the current manual of survey instructions of the United States Department of the Interior, Bureau of Land Management or by a decree of a Court of Law and/or that the corner points mentioned in lines 3, 4 and 5 above were in conformance with the rules of the Michigan Board of Land Surveyors or by a Decree of a Court of Law, established, re-established, monumented, re-monumented, recovered, found as expressed below:

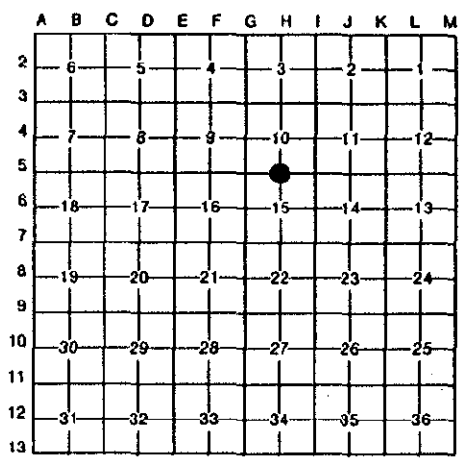

NOTE: Not more than 4 corners, all in the same town and range, may be recorded on this certificate.

A. Description of original monument and accessories and/or subsequent restoration:

Corner established by A. Merryweather of 6/16/1852. Original B.T.s --- 6" Sugar N.55 E. 4 links (2.64') --- 8" Birch N.50 W. 23 links (15.18') ---

Corner re-established by Gary L. Pison (27457) on 11/11/91 by single proportionate methods. He set a 2" X 30" aluminum pipe with a 3/4" stamped aluminum cap and the following new bearing trees:

16"	White Spruce	S.66 E.	18.59'
5"	Red Maple	S.57 W.	26.41'
6"	Sugar Maple	N.08 E.	22.49'
6'	Steel sign post	South	0.75'

B. Description of corner evidence found and/or method applied in restoring or reestablishing corner:

Corner recorded in Gogebic County Liber 4, Page 140 on 10/7/92.

Corner research on file with Gogebic County records.

Recovered the monument as described and the bearing trees as follows:

17"	White Spruce	S.68 E.	18.59'
6"	Red Maple	S.58 W.	26.41'
6"	Sugar Maple	N.07 E.	22.48'
6'	Steel sign rail	S.08 E.	0.69'

No evidence of the original B.T.s remain.

C. Description of monument for corner and accessories established to perpetuate locating the position of the corner:

New bearing tree referenced:

9" Red Maple S.14 E. 51.83'

FREE GROUP APPROVED
Richard L. Drahn 12/19/97
COUNTY CLERK



Signed by Richard L. Drahn Date December 15, 1997
Surveyor's Michigan License No. 21564