

LAND CORNER RECORDATION CERTIFICATE
Filing Requirement of Act 74, Mich. P.A. 1970

Register's Office }
Gogebic County } ss.

For corners in

Gogebic
(County)

Located In:

Corner Code #

- 1. Public Land Survey T 45N R 41W H-11
T _____ R _____
T _____ R _____
- 2. Property Controlling PEER GROUP Approved
in Section S _____ T _____ R _____
S _____ T _____ R _____
- 3. Miscellaneous Richard P. Deahn 5/25/94
Property in Sec. S _____ T _____ R _____

Received for record the
15th day of JUNE
A. D. 1994 at 1:45 o'clock
7 m., and recorded in
Liber 5 of CORNERS
on page 66
Richard J. Brown Jr
Register of Deeds
Register of Deeds Stamp & File Number

- 4. Lot No. _____, Recorded Plat _____
- 5. Private Claims _____

Quarter corner between Sections 27 and 34.

I, Gary L. Pisoni, in a field survey on December 18, 19 93, do hereby certify that under requirements of P.A. 74, Michigan P.A. of 1970, the corner points mentioned in lines 1 and 2 above were in conformance with regulations and rules therefore as required in the current manual of survey instructions of the United States Department of the Interior, Bureau of Land Management or by a decree of a Court of Law and/or that the corner points mentioned in lines 3, 4 and 5 above were in conformance with the rules of the Michigan Board of Land Surveyors or by a Decree of a Court of Law; established, re-established, monumented, re-monumented, recovered, found as expressed below:

	A	B	C	D	E	F	G	H	I	J	K	L	M
2	6		5		4		3		2		1		
3													
4	7		8		9		10		11		12		
5													
6	18		17		16		15		14		13		
7													
8	19		20		21		22		23		24		
9													
10	30		29		28		27		26		25		
11													
12	31		32		33		34		35		36		
13													

NOTE: Not more than 4 corners, all in the same town and range, may be recorded on this certificate.

A. Description of original monument and accessories and/or subsequent restoration:

Original corner established by Algernon Merryweather, U.S. Deputy Surveyor on June 14, 1852.
Original corner: Wood Post
Original Bearing Trees:
Sugar 10" N 70° E 11 Links (7.26 feet)
Sugar 6" S 75° W 10 Links (6.60 feet)


B. Description of corner evidence found and/or method applied in restoring or reestablishing corner:

No evidence remains of original corner or bearing trees. Corner position found marked by a 4" X 4" X 3" post. Wood Post set by unknown person. Wood post has been used for lot surveys on Clearwater Lake. I accept the wood post as the best available evidence for restoring the corner position. Wood post lies on South side of a logging road.
Replaced wood post with an aluminum pipe monument as described below.

C. Description of monument for corner and accessories established to perpetuate locating the position of the corner:

At the corner position, I set a 2" diameter by 30" long split base aluminum pipe monument with a 3" cast aluminum cap, stamped to read: T45N, R41W, 1/4, S-27, S-34, 1993, RLS- 27457 from which I established the following new blazed and scribed bearing trees: (all measurements taken to a nail in side of tree)

Sugar Maple	5"	S 20° E	16.98 feet
Sugar Maple	8"	S 54° W	37.88 feet
Sugar Maple	6"	N 25° W	31.59 feet
Steel Sign Post		South	0.96 feet

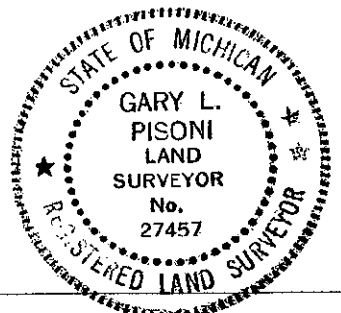

Signed by Gary L. Pisoni Date 4-1-94

Surveyor's Michigan License No. 27457