

**SURVEY &  
REMONUMENTATION**

**JAN 22 1998**

**SECTION**

**LAND CORNER RECORDATION CERTIFICATE  
Filing Requirement of Act 74, Mich. P.A. 1970**

For corners in

Gogebic (County) Located In: Corner Code #  
 1. Public Land Survey T 45N R 41W T-7  
 T \_\_\_ R \_\_\_  
 T \_\_\_ R \_\_\_  
 T \_\_\_ R \_\_\_  
 2. Property Controlling S \_\_\_ T \_\_\_ R \_\_\_  
 in Section S \_\_\_ T \_\_\_ R \_\_\_  
 3. Miscellaneous S \_\_\_ T \_\_\_ R \_\_\_  
 Property in Sec. S \_\_\_ T \_\_\_ R \_\_\_

Register's Office }  
Gogebic County } ss.

Received for record the  
22<sup>ND</sup> day of DECEMBER  
A. D. 1997 at 11:00 o'clock  
A m., and recorded in  
Liber 6 of CORNERS  
on page 292  
Ramona Collins, Deputy  
Register of Deeds

Register of Deeds Stamp & File Number

4. Lot No. \_\_\_\_\_, Recorded Plat \_\_\_\_\_  
5. Private Claims \_\_\_\_\_

Section Corner 14, 15, 22 & 23; T.45 N., R.41 W.

I, Richard L. Drahn in a field survey on December 13, 19 97, do hereby certify that under requirements of P.A. 74, Michigan P.A. of 1970, the corner points mentioned in lines 1 and 2 above were in conformance with regulations and rules therefore as required in the current manual of survey instructions of the United States Department of the Interior, Bureau of Land Management or by a decree of a Court of Law and/or that the corner points mentioned in lines 3, 4 and 5 above were in conformance with the rules of the Michigan Board of Land Surveyors or by a Decree of a Court of Law; established, re-established, monumented, re-monumented, recovered, found as expressed below:

**NOTE: Not more than 4 corners, all in the same town and range, may be recorded on this certificate.**

	A	B	C	D	E	F	G	H	I	J	K	L	M
2	6		5		4		3		2		1		
3													
4	7		8		9		10		11		12		
5													
6	18		17		16		15		14		13		
7													
8	19		20		21		22		23		24		
9													
10	30		29		28		27		26		25		
11													
12	31		32		33		34		35		36		
13													

A. Description of original monument and accessories and/or subsequent restoration:

Corner established by A. Merryweather on 6/10/1852. Original B.T.s --- 8" Birch S.54 E. 43 links (28.38') --- 20" Birch N.72 W. 20 links (13.20')---

Gary L. Pisoni (27457) on 12/18/89 monumented the corner at the site of a squared wood post. He set a 2" X 30" aluminum pipe with a 3 1/4" stamped aluminum cap and the following new B.T.s:

16" Yellow Birch N.04 E. 4.68'  
 8" Red Maple S.83 E. 13.31'  
 8" Red Maple S.60 W. 15.30'  
 6' Steel sign post S.45 E. 1.00'

B. Description of corner evidence found and/or method applied in restoring or reestablishing corner:

Corner recorded in Gogebic County Liber 4, Page 53 on 1/22/92.

Corner research on file with Gogebic County records.

Recovered the monument as described and the bearing trees as follows:

16" Yellow Birch N.03 E. 4.65'  
 9" Red Maple S.83 E. 13.32'  
 9" Red Maple S.60 W. 15.30'  
 6' Steel sign rail S.46 E. 0.94'

No evidence of the GLO bearing trees remain.


C. Description of monument for corner and accessories established to perpetuate locating the position of the corner:

New bearing tree referenced:

5" Balsam N.59 E. 22.77'

PEER GROUP APPROVED

Richard L. Drahn 12/19/97  
COUNTY REGISTRAR

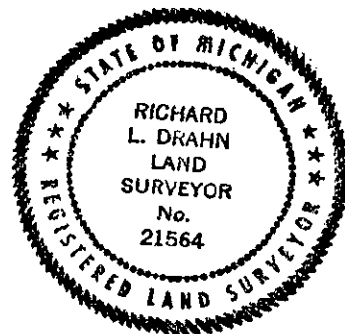

Signed by Richard L. Drahn Date December 15, 1997

Surveyor's Michigan License No. 21564