

Register's Office }
Gogebic County } ss.

LAND CORNER RECORDATION CERTIFICATE
Filing Requirement of Act 74, Mich. P.A. 1970

Received for record the
29th day of SEPTEMBER

A. D. 1993 at 9:30 o'clock
A m., and recorded in

Liber 4 of CORNERS
on page 257 281

Betty Harris Deputy
Register of Deeds

Register of Deeds Stamp & File Number

For corners in
Gogebic
(County)

Located In: Corner Code #/

1. Public Land Survey	T <u>45N</u> R <u>41W</u>	<u>K-5</u>
	T _____ R _____	_____
	T _____ R _____	_____
	T _____ R _____	_____
2. Property Controlling in Section	S _____ T _____ R _____	_____
	S _____ T _____ R _____	_____
3. Miscellaneous Property in Sec.	S _____ T _____ R _____	_____
	S _____ T _____ R _____	_____

PEER GROUP **Approved**

4. Lot No. _____, Recorded Plat _____
5. Private Claims Richard L. Doolin 1/20/98

	A	B	C	D	E	F	G	H	I	J	K	L	M
2	6	5	4	3	2	1							
3													
4	7	8	9	10	11	12							
5													
6	18	17	16	15	14	13							
7													
8	19	20	21	22	23	24							
9													
10	30	29	28	27	26	25							
11													
12	31	32	33	34	35	36							
13													

I, Gary L. Pisoni, in a field survey on Oct. 24, 19 91, do hereby certify that under requirements of P.A. 74, Michigan P.A. of 1970, the corner points mentioned in lines 1 and 2 above were in conformance with regulations and rules therefore as required in the current manual of survey instructions of the United States Department of the Interior, Bureau of Land Management or by a decree of a Court of Law and/or that the corner points mentioned in lines 3, 4 and 5 above were in conformance with the rules of the Michigan Board of Land Surveyors or by a Decree of a Court of Law; established, re-established, monumented, re-monumented, recovered, found as expressed below:

NOTE: Not more than 4 corners, all in the same town and range, may be recorded on this certificate.

A. Description of original monument and accessories and/or subsequent restoration:

Original corner established by A. Merryweather, U.S. Deputy Surveyor on June 9, 1852
Original corner: Wood post
Original bearing trees:

Tamarack	12"	S 55°W	10 links (6.60 feet)
Balsam	8"	N 75°E	21 links (13.86 feet)

B. Description of corner evidence found and/or method applied in restoring or reestablishing corner:

No original corner evidence found. At the corner position, found a wood post rotted at ground line. Wood post falls in the vicinity of the mathematical position for the section corner.


I accepted the rotted wood post as the best available evidence for restoring the corner position.

C. Description of monument for corner and accessories established to perpetuate locating the position of the corner:

At the corner position, I set a 3/4" outside diameter by 7 feet long aluminum rod monument with a 3" cast aluminum cap, stamped to read: T45N, R41W, S-11, S-12, S-13, S-14, 1991, RLS 27457; from which I established the following new blazed and scribed bearing trees: (all measurements taken to a nail in side of tree)

Cedar	11"	N 86°E	30.59 feet
Spruce	10"	S 27°W	32.21 feet
Cedar	7"	N 52°W	17.09 feet
Steel sign post		South	0.80 feet

Signed by Gary L. Pisoni Date Sept. 20th 1993
Surveyor's Michigan License No. 27457

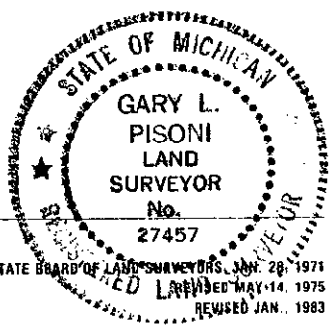

FORM APPROVED BY MICHIGAN STATE BOARD OF LAND SURVEYORS, JUN. 28, 1971
REVISOR L. J. HARRIS, MAY 14, 1975
REVISOR J. J. HARRIS, JAN. 1983