

LAND CORNER RECORDATION CERTIFICATE
Filing Requirement of Act 74, Mich. P.A. 1970

For corners in

Register's Office } ss.
Gogebic County }

Received for record the
15 day of June
A. D. 1994 at 1:45 o'clock
9 m., and recorded in
Liber 5 of COGNAC
on page 70
Richard J. Brown
Register of Deeds

Gogebic (County) Located In: Corner Code #

1. Public Land Survey T 45N R 41W L-1
T R
T R
T R

2. Property Controlling in Section **PEER GROUP** Approved
S T R
Richard L. Deal

3. Miscellaneous Property in Sec. 5/25/94

4. Lot No. _____, Recorded Plat _____

5. Private Claims _____

Register of Deeds Stamp & File Number

Quarter Corner, Sections 36 and 1, T45-46N, R41W.

I, Gary L. Pisoni, in a field survey on January 13, 19 92, do hereby certify that under requirements of P.A. 74, Michigan P.A. of 1970, the corner points mentioned in lines 1 and 2 above were in conformance with regulations and rules therefore as required in the current manual of survey instructions of the United States Department of the Interior, Bureau of Land Management or by a decree of a Court of Law and/or that the corner points mentioned in lines 3, 4 and 5 above were in conformance with the rules of the Michigan Board of Land Surveyors or by a Decree of a Court of Law; established, re-established, monumented, re-monumented, recovered, found as expressed below:

A	B	C	D	E	F	G	H	I	J	K	L	M
2	6	5	4	3	2	1						
3												
4	7	8	9	10	11	12						
5												
6	18	17	16	15	14	13						
7												
8	19	20	21	22	23	24						
9												
10	30	29	28	27	26	25						
11												
12	31	32	33	34	35	36						
13												

NOTE: Not more than 4 corners, all in the same town and range, may be recorded on this certificate.

A. Description of original monument and accessories and/or subsequent restoration:

Original corner established by William A. Burt, U.S. Deputy Surveyor in July, 1847.
Original corner: Tamarack Post
Original Bearing Trees:
Tamarack 12" N 31° E 15 links (9.90 feet)
Tamarack 5" N 36° W 25 links (16.50 feet)


B. Description of corner evidence found and/or method applied in restoring or reestablishing corner:

No original corner evidence found. Corner restored by single proportionate measurement on line between the Northeast and Northwest Section corners of Section 1.

C. Description of monument for corner and accessories established to perpetuate localing the position of the corner:

At the corner position, I set a 3/4" outside diameter by 8 feet long aluminum rod monument with a 3" cast aluminum cap, stamped to read: T46N, R41W, 1/4, S-36, S-1, T45N, 1991, RLS- 27457 from which I established the following new blazed and scribed bearing trees: (all measurements taken to a nail in side of tree)

Black Spruce 5" S 41° W 9.30 feet
Black Spruce 4" N 78° E 30.00 feet
Black Spruce 6" N 01° W 21.24 feet
Steel Sign Post West 0.97 feet

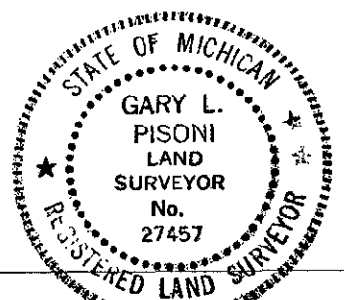

Signed by Gary L. Pisoni Date 4-1-94

Surveyor's Michigan License No. 27457