

MAY 16 1997

COMMISSION

**LAND CORNER RECORDATION CERTIFICATE**  
Filing Requirement of Act 74, Mich. P.A. 1970

Register's Office }  
Gogebic County } ss.

For corners in Gogebic Located In: \_\_\_\_\_ Corner Code # \_\_\_\_\_  
(County)

Received for record the  
17<sup>th</sup> day of OCTOBER  
A. D. 1996 at 9:50 o'clock  
A m., and recorded in  
Liber 6 of CORNERS  
on page 65

Ramona Collins Deputy  
Register of Deeds

Register of Deeds Stamp & File Number

- 1. Public Land Survey Section 19 T 45N R 41W \_\_\_\_\_ A-9  
T 45N R 42W \_\_\_\_\_ M-9  
T \_\_\_\_\_ R \_\_\_\_\_  
T \_\_\_\_\_ R \_\_\_\_\_
- 2. Property Controlling S \_\_\_\_\_ T \_\_\_\_\_ R \_\_\_\_\_  
in Section S \_\_\_\_\_ T \_\_\_\_\_ R \_\_\_\_\_
- 3. Miscellaneous S \_\_\_\_\_ T \_\_\_\_\_ R \_\_\_\_\_  
Property in Section S \_\_\_\_\_ T \_\_\_\_\_ R \_\_\_\_\_
- 4. Lot No. \_\_\_\_\_, Recorded Plat \_\_\_\_\_
- 5. Private Claims \_\_\_\_\_

The section corner common to Sections 24, 19, 25 and 30, T45N, R42-41W.

I, John R. Garske, in a field survey on September 24, 19 96  
do hereby certify that under requirements of P.A. 74, Michigan P.A. of 1970, the corner points mentioned  
in lines 1 and 2 above were in conformance with regulations and rules therefore as required in the current  
manual of survey instructions of the United States Department of the Interior, Bureau of Land  
Management or by a decree of a Court of Law and/or that the corner points mentioned in lines 3, 4 and  
5 above were in conformance with the rules of the Michigan Board of Professional Surveyors or by a  
Decree of a Court of Law; established, re-established, monumented, re-monumented, recovered, found  
as expressed below:

	A	B	C	D	E	F	G	H	I	J	K	L	M
2	6		5		4		3		2		1		
3													
4	7		8		9		10		11		12		
5													
6	18		17		16		15		14		13		
7													
8	19		20		21		22		23		24		
9													
10	30		29		28		27		26		25		
11													
12	31		32		33		34		35		36		
13													

**NOTE: Not more than 4 corners, all in the same town and range, may be recorded on this certificate.**

**A. Description of original monument and accessories and/or subsequent restoration:**

In 1847, William Burt, U.S. Deputy Surveyor, set a wooden post with the following bearing trees:  
18" hemlock - S75°E - 26 links  
18" hemlock - S65°W - 12 links  
7" hemlock - N42°E - 26 links

In 1974, Richard Drahn, RLS, set a 2 1/2" pipe with a brass tablet and established the following bearing trees and reference objects:  
7" cedar - N60°W - 43.6 feet  
6" blk ash - N10°W - 41.1 feet  
4" x 4" x 7' cedar sign post - S89°W - 3.5 feet  
7" white spruce - S50°W - 36.0 feet

**B. Description of corner evidence found and/or method applied in restoring or reestablishing corner:**

I located the pipe with brass tablet, cedar sign post, and three bearing trees. Two of the existing bearing trees were in poor condition so I established two new bearing trees and a sign post as noted below.


P.A. 74 research on file.

**PEER GROUP APPROVED**  
Richard P. Drahn 10/16/96  
COUNTY REPRESENTATIVE

**C. Description of monument for corner and accessories established to perpetuate locating the position of the corner:**

I established the following bearing trees and reference objects:  
14" cedar - N51°W - 43.49 feet (existing)  
5" balsam - N58°E - 12.19 feet (new)  
5" balsam - S43°E - 7.50 feet (new)  
6' steel sign rail - south - 1.16 feet (new)

All bearing trees were blazed, painted, scribed and tagged.

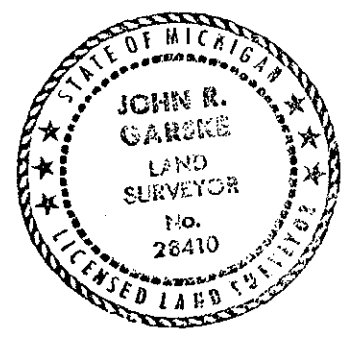

Signed by John R. Garske  
Surveyor's Michigan License No. 28410

Date 10-15-96