

**SURVEY & REMONUMENTATION**

JUN 29 1995

COMMISSION

map  
COMP

**LAND CORNER RECORDATION CERTIFICATE**  
Filing Requirement of Act 74, Mich. P.A. 1970

For corners in  
Gogebic  
(County)

Located In:	Corner Code #
1. Public Land Survey T <u>45N</u> R <u>43W</u>	<u>B-5</u>
T _____ R _____	_____
T _____ R _____	_____
T _____ R _____	_____
2. Property Controlling S _____ T _____ R _____	_____
in Section S _____ T _____ R _____	_____
3. Miscellaneous S _____ T _____ R _____	_____
Property in Sec. S _____ T _____ R _____	_____

Register's Office }  
Gogebic County } ss.

Received for record the  
26<sup>th</sup> day of JANUARY  
A. D. 1995 at 10:45 o'clock  
A m., and recorded in  
Liber 5 of CORNERS  
on page 176.

Register of Deeds

Register of Deeds Stamp & File Number

4. Lot No. \_\_\_\_\_, Recorded Plat \_\_\_\_\_  
5. Private Claims \_\_\_\_\_

One-quarter corner common to Sections 7 and 18, T45N, R43W

January 10 1995

I, John R. Garske, in a field survey on \_\_\_\_\_, 19\_\_\_\_\_, do hereby certify that under requirements of P.A. 74, Michigan P.A. of 1970, the corner points mentioned in lines 1 and 2 above were in conformance with regulations and rules therefore as required in the current manual of survey instructions of the United States Department of the Interior, Bureau of Land Management or by a decree of a Court of Law and/or that the corner points mentioned in lines 3, 4 and 5 above were in conformance with the rules of the Michigan Board of Land Surveyors or by a Decree of a Court of Law; established, re-established, monumented, re-monumented, recovered, found as expressed below:

	A	B	C	D	E	F	G	H	I	J	K	L	M
2	6	5	4	3	2								
3													
4	7	8	9	10	11	12							
5	•												
6	18	17	16	15	14	13							
7													
8	19	20	21	22	23	24							
9													
10	30	29	28	27	26	25							
11													
12	31	32	33	34	35	36							
13													

**NOTE: Not more than 4 corners, all in the same town and range, may be recorded on this certificate.**

A. Description of original monument and accessories and/or subsequent restoration:

Original survey by Algernon Merryweather in 1852. Set post from which a 6" balsam bears S35°W, 10 links and a 7" balsam - N48°E, 27 links.

B. Description of corner evidence found and/or method applied in restoring or reestablishing corner:

No original evidence could be found due to logging activity. Corner was set on line between section corners at a proportionate distance in accordance to the original general land office survey notes.

Record research on file with the Register of Deeds office.

See sketch on back.

**PEER GROUP**

**Approved**

Richard P. Wood


1/25/95

C. Description of monument for corner and accessories established to perpetuate locating the position of the corner:

Set a 1-4 foot section of 3/4" diameter aluminum marshrod with a 3 1/4" diameter aluminum cap stamped: T45N, R43W; 1/4; S-7; S-18; 1995; RLS 28410. I established the following bearing trees and reference object: 8" cedar - S88°E, 35.82 feet; 4" B. ash - S52°W, 29.26 feet; 6" B. ash - N20°W, 19.11 feet; 6" steel rail with sign - south - 1.13 feet.

Signed by John R. Garske  
Surveyor's Michigan License No. 28410

Date 1-17-95

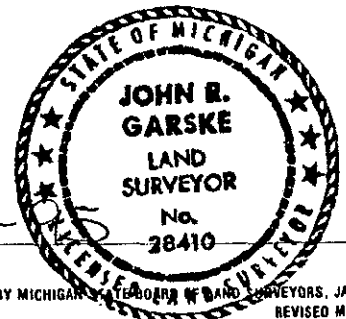

SKETCH  
NO SCALE



(B-5)  
1/4 COR.

