

SURVEY & REMONUMENTATION

JUN 29 1995

COMMISSION

LAND CORNER RECORDATION CERTIFICATE
Filing Requirement of Act 74, Mich. P.A. 1970

Register's Office }
Gogebic County } ss.

Received for record the
26TH day of JANUARY
A. D. 1995 at 10:45 o'clock
A m., and recorded in
Liber 5 of CORNERS
on page 175

Register of Deeds

Register of Deeds Stamp & File Number

For corners in

Gogebic

(County)

Located In:

Corner Code #

1. Public Land Survey	T	45N	R	43W	C-4
	T		R		
	T		R		
	T		R		
2. Property Controlling in Section	S		T	R	
	S		T	R	
3. Miscellaneous Property in Sec.	S		T	R	
	S		T	R	

4. Lot No. _____, Recorded Plat _____

5. Private Claims _____

One-quarter corner common to Sections 7 and 8, T45N, R43W

January 3 1995

I, John R. Garske, in a field survey on _____, 19 _____, do hereby certify that under requirements of P.A. 74, Michigan P.A. of 1970, the corner points mentioned in lines 1 and 2 above were in conformance with regulations and rules therefore as required in the current manual of survey instructions of the United States Department of the Interior, Bureau of Land Management or by a decree of a Court of Law and/or that the corner points mentioned in lines 3, 4 and 5 above were in conformance with the rules of the Michigan Board of Land Surveyors or by a Decree of a Court of Law; established, re-established, monumented, re-monumented, recovered, found as expressed below:

NOTE: Not more than 4 corners, all in the same town and range, may be recorded on this certificate.

A. Description of original monument and accessories and/or subsequent restoration:

Original survey notes by Algernon Merryweather in 1852, state that the "quarter section corner in pond."

B. Description of corner evidence found and/or method applied in restoring or reestablishing corner:

There is an apparent error in the original government survey, as this corner position did not fall in the pond as noted. I established the corner position by a weighted mean bearing using the monumented north and south section lines.

See sketch on back.

Record research on file with the Register of Deeds office.

PEER GROUP

Approved

Richard P. Deal


1/25/95

C. Description of monument for corner and accessories established to perpetuate locating the position of the corner:

Set a 2 1/2" x 30" aluminum monument with a 3 1/4" aluminum cap stamped: T45N, R43W; 1/4; S-7; S-8; 1995; RLS 28410. I established the following bearing trees and reference object: 4" W. spruce - N57°E, 17.78 feet; 12" W. spruce - S34°W, 15.20 feet; 6" B. spruce - N43°W, 69.28 feet (slope distance); 6' steel rail with sign - S22°E, 1.78 feet.

Signed by John R. Garske
Surveyor's Michigan License No. 28410

Date 1-17-95

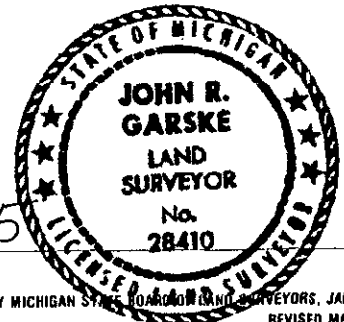

SKETCH

EAST LINE OF
SECTION 7, T45N, R43W

