

MAR 02 2000

SECTION

LAND CORNER RECORDATION CERTIFICATE
Filing Requirement of Act 74, Mich. P.A. 1970

Register's Office }
Gogebic County } ss.

Received for record the
26TH day of AUGUST
A. D. 1999 at 1:35 o'clock
P m., and recorded in
Lib. 7 of CORNERS
on page 216
Amena Collins, Deputy
Register of Deeds

Register of Deeds Stamp & File Number


For corners in

<u>Gogebic</u> (County)	Located In:	Corner Code #
1. Public Land Survey Section 8	<u>T45N R43W</u>	<u>D-5</u>
	T <u> </u> R <u> </u>	<u> </u>
	T <u> </u> R <u> </u>	<u> </u>
	T <u> </u> R <u> </u>	<u> </u>
2. Property Controlling in Section	S <u> </u> T <u> </u> R <u> </u>	<u> </u>
	S <u> </u> T <u> </u> R <u> </u>	<u> </u>
3. Miscellaneous Property in Sec.	S <u> </u> T <u> </u> R <u> </u>	<u> </u>
	S <u> </u> T <u> </u> R <u> </u>	<u> </u>

4. Lot No. _____, Recorded Plat _____
5. Private Claims _____
1/4 corner to sections 8 & 17, T45N, R43W

I, John R. Garske, August 18, 1999 do hereby state that under requirements of P.A. 74, Michigan P.A. of 1970, the corner points mentioned in lines 1 and 2 above were in conformance with regulations and rules therefore as required in the current manual of survey instructions of the United States Department of the Interior, Bureau of Land Management or by a decree of a Court of Law and /or that the corner points mentioned in lines 3, 4 and 5 above were in conformance with the rules of the Michigan Board of Land Surveyors or by a Decree of a Court of Law, established, re-established, monumented, recovered, found as expressed below:

NOTE: Not more than 2 corners, all in the same town and range, may be recorded on this certificate.

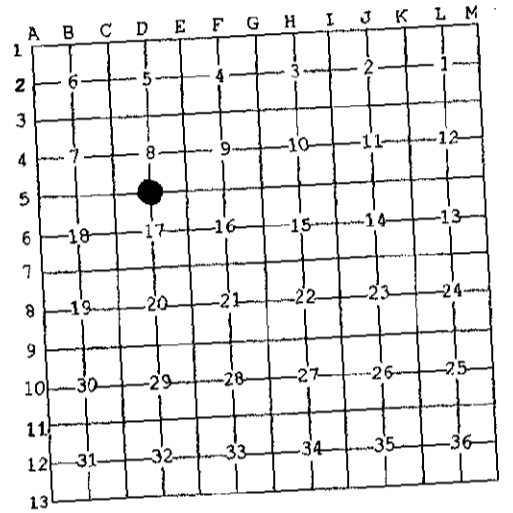

A. Description of original monument and accessories and/or subsequent restoration:

Original survey by Algernon Merryweather, D.S. July 1852.
Original corner; wood post from which:
a hemlock 12" S40°E 13 links
a balsam 7" N53°W 29 links

B. Description of corner evidence found and/or method applied in restoring or reestablishing corner:

I searched for evidence of the original corner at a proportioned location and found no remains of either bearing trees. I monumented the corner at a single proportioned position, on line and at the mid point between section corners in accordance with the original notes.

(Research on file)

BEER GROUP APPROVED
Richard P. Deahn 8/24/99
COUNTY REGISTER

C. Description of monument for corner and accessories established to perpetuate locating the position of the corner:

At the 1/4 corner position I set a 3/4" dia. aluminium rod with a 3 1/4" dia alum. cap stamped to identify the corner, from which:
7" w. spruce N04°W 6.62 feet
6" balsam N67°W 19.26 feet
6" R. maple S30°W 25.20 feet
steel sign rail S29°W 1.34 feet



Signed by John R. Garske
Surveyor's Michigan License No. 28410

Date 8/24/99