

MAR 02 2000

SECTION

LAND CORNER RECORDATION CERTIFICATE
Filing Requirement of Act 74, Mich. P.A. 1970

For corners in

Gogebic
(County)

Located in:	Section	T ₈	R _{15N}	43W	E-5
		T	R		
		T	R		
		T	R		
	S	T	R		
	S	T	R		
	S	T	R		
	S	T	R		

1. Public Land Survey

2. Property Controlling in Section

3. Miscellaneous Property in Sec.

4. Lot No. _____, Recorded Plat _____
5. Private Claims _____

Register's office }
Gogebic County } ss.


Received for record the
26TH day of AUGUST
A. D. 1999 at 1:35 o'clock
P m., and recorded in
Liber 7 of CORNERS
on page 219
Dorinda Collins Deputy
Register of Deeds

Register of Deeds Stamp & File Number

Section Corner to 8, 9, 16 & 17, T45N, R43W

John R. Garske in a field survey on August 10, 1999 hereby state that under requirements of P.A. 74, Michigan P.A. of 1970, the corner points mentioned in lines 1 and 2 above were in conformance with regulations and rules therefore as required in the current manual of survey instructions of the United States Department of the Interior, Bureau of Land Management or by a decree of a Court of Law and /or that the corner points mentioned in lines 3, 4 and 5 above were in conformance with the rules of the Michigan Board of Land Surveyors or by a Decree of a Court of Law; established, re-established, monumented, recovered, found as expressed below.

NOTE: Not more than 2 corners, all in the same town and range, may be recorded on this certificate.

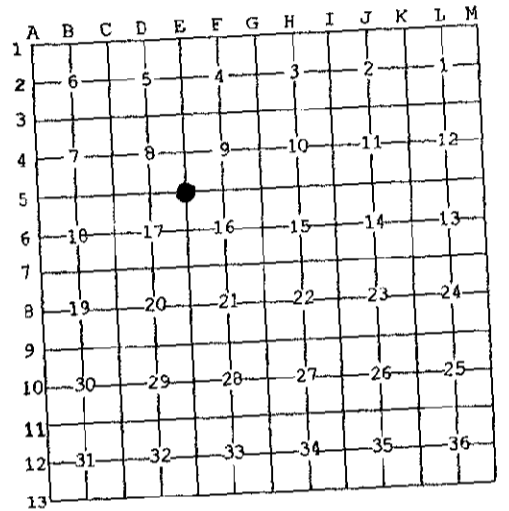

A. Description of original monument and accessories and/or subsequent restoration:

Original survey by Algernon Merryweather, D.S., July 1852.
Original Bearing trees:
Birch 9" N55°W 16 links (10.56 feet)
Balsam 6" S40°E 16 links (10.56 feet)

B. Description of corner evidence found and/or method applied in restoring or reestablishing corner:

I positioned a corner search area using the GLO creek calls north 9.60 chains (633.60') and east 7.32 chains (483.12') and the ascend hill at 10 chains (660') east. At the corner search area I found the decayed remains of the birch bearing tree, consisting of a large stump hole with decayed y. birch roots and bark. A 20" to 30" stump hole with root holes evident was all that remained of the Balsam bearing tree. This position is consistent with the other retracable natural feature ties.
(Research on file)

DEED GROUP APPROVED
Richard L. Decker 8/24/99
COUNTY CLERK

C. Description of monument for corner and accessories established to perpetuate locating the position of the corner:

At the corner position I set a 2" dia x 30" alum. pipe monument with a 3 1/4" stamped alum. cap from which:
Steel sign rail N40°E 1.19 feet
10" twin sugar S78°E 7.11 feet
9" sugar S7°W 21.95 feet
10" sugar S53°W 28.74 feet

Signed by John R. Garske
Surveyor's Michigan License No. 28410

Date 8/24/99

