

MAR 02 2000

SECTION

LAND CORNER RECORDATION CERTIFICATE  
Filing Requirement of Act 74, Mich. P.A. 1970

Register's Office }  
Gogebic County } ss.

Received for record the  
26<sup>TH</sup> day of AUGUST  
A. D. 1999 at 1:35 o'clock  
9 m., and recorded in  
Liber 7 of CORNERS  
on page 220  
Namona Collins Deputy  
Register of Deeds

For corners in


<u>Gogebic</u> (County)	Located In:	Corner Code #
1. Public Land Survey Section 16	T <u>45N</u> R <u>43W</u>	E- <u>7</u>
	T <u>   </u> R <u>   </u>	<u>   </u>
	T <u>   </u> R <u>   </u>	<u>   </u>
	T <u>   </u> R <u>   </u>	<u>   </u>
2. Property Controlling in Section	S <u>   </u> T <u>   </u> R <u>   </u>	<u>   </u>
	S <u>   </u> T <u>   </u> R <u>   </u>	<u>   </u>
3. Miscellaneous Property in Sec.	S <u>   </u> T <u>   </u> R <u>   </u>	<u>   </u>
	S <u>   </u> T <u>   </u> R <u>   </u>	<u>   </u>

Register of Deeds Stamp & File Number

4. Lot No. \_\_\_\_\_, Recorded Plat \_\_\_\_\_  
5. Private Claims \_\_\_\_\_

Section Corner common to sections 16, 17, 20, 21, T45N, R43W  
John R. Garske June 23, 99

I, \_\_\_\_\_, in a field survey on \_\_\_\_\_, 19\_\_\_\_ do hereby state that under requirements of P.A. 74, Michigan P.A. of 1970, the corner points mentioned in lines 1 and 2 above were in conformance with regulations and rules therefore as required in the current manual of survey instructions of the United States Department of the Interior, Bureau of Land Management or by a decree of a Court of Law and for that the corner points mentioned in lines 3, 4 and 5 above were in conformance with the rules of the Michigan Board of Land Surveyors or by a Decree of a Court of Law; established, re-established, monumented, recovered, found as expressed below:

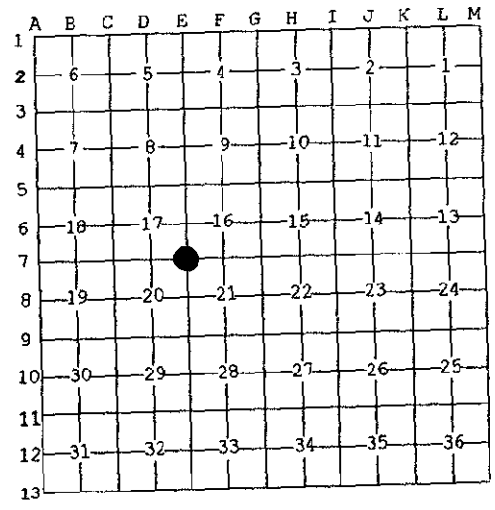

NOTE: Not more than 2 corners, all in the same town and range, may be recorded on this certificate.

A. Description of original monument and accessories and/or subsequent restoration:

Original corner set by Algernon Merryweather, D.S., July 1852.  
Original Bearing trees:  
Cedar 8" N65°E 9 links  
Cedar 6" S40°W 8 links  
Corner restored in 1977 by Richard Drahn, RLS #21564, rec. Liber 1, Page 204. He set a 2 1/2" concrete filled pipe with a 3" diameter brass cap stamped from which;  
9" Hemlock S69°W 24.3 feet  
7" Sugar Maple N11°E 28.1 feet  
4" Red Maple N89°E 18.2 feet  
7" Sign post N44°W 2.7 feet

B. Description of corner evidence found and/or method applied in restoring or reestablishing corner:

DEED GROUP APPROVED  
Richard R. Drahn 8/24/99  
COUNTY REGISTRAR

I found the monument and accessories as described above. I set nails in the trees and recorded new ties as noted below with one new B.T. established.

(Research on file)

C. Description of monument for corner and accessories established to perpetuate locating the position of the corner:

Established the following witnesses:

Sign Post	N41°W	2.63 feet (existing)
12" Hemlock	S75°W	23.82 feet (existing)
10" maple	N18°E	27.98 feet (existing)
8" maple	S82°E	17.92 feet (existing)
8" maple	S25°W	12.61 feet (new)



Signed by John R. Garske  
Surveyor's Michigan License No. 28410

Date 8/24/99