

MAR 02 2000

SECTION

LAND CORNER RECORDATION CERTIFICATE
Filing Requirement of Act 74, Mich. P.A. 1970

For corners in

<u>Gogebic</u> (County)	Located In:	Corner Code #
1. Public Land Survey Section 16	T <u>45N</u> R <u>43W</u>	F-7
	T _____ R _____	_____
	T _____ R _____	_____
	T _____ R _____	_____
2. Property Controlling in Section	S _____ T _____ R _____	_____
	S _____ T _____ R _____	_____
3. Miscellaneous Property in Sec.	S _____ T _____ R _____	_____
	S _____ T _____ R _____	_____

Register's Office }
Gogebic County } ss.

Received for record the
26TH day of AUGUST
A. D. 1999 at 1:35 o'clock
P. m., and recorded in
Liber 7 of CORNERS
page 221
Ramona Collins, Deputy
Register of Deeds

Register of Deeds Stamp & File Number

4. Lot No. _____, Recorded Plat _____
5. Private Claims _____

Quarter corner common to sections 16 & 21

I, John R. Garske in a field survey on June 23, 1999 do hereby state that under requirements of P.A. 74, Michigan P.A. of 1970, the corner points mentioned in lines 1 and 2 above were in conformance with regulations and rules therefore as required in the current manual of survey instructions of the United States Department of the Interior, Bureau of Land Management or by a decree of a Court of Law and /or that the corner points mentioned in lines 3, 4 and 5 above were in conformance with the rules of the Michigan Board of Land Surveyors or by a Decree of a Court of Law; established, re-established, monumented, recovered, found as expressed below:

NOTE: Not more than 2 corners, all in the same town and range, may be recorded on this certificate.

A	B	C	D	E	F	G	H	I	J	K	L	M
1												
2	6		5		4		3		2		1	
3												
4	7		8		9		10		11		12	
5												
6	18		17		16		15		14		13	
7												
8	19		20		21		22		23		24	
9												
10	30		29		28		27		26		25	
11												
12	31		32		33		34		35		36	
13												

A. Description of original monument and accessories and/or subsequent restoration:

Original survey by Algernon Merryweather, D.S. July 1852.
Original bearing trees:

Sugar 12" N60°W 3 links
Ironwood 6" S12°E 11 links

Corner restored by Richard Drahn, RLS # 21564 in February 1977, recorded L1 pg. 207. He monumented the corner from remains of the two original bearing trees. He set a 2" concrete filled iron pipe with a 3" dia. bronze stamped cap from which:

5" sugar maple N75°W 8.2 feet
6" sugar maple N45°E 29.6 feet
8" sugar maple S35°E 32.8 feet
metal sign post N02°E 3.4 feet

B. Description of corner evidence found and/or method applied in restoring or reestablishing corner:

PEER GROUP APPROVED

Richard H. Drahn 8/24/99
COUNTY REGISTER


I found the monument and accessories as described above. I set nails in all the trees and recorded new ties as noted below with one new B.T. established.

(Research on file)

C. Description of monument for corner and accessories established to perpetuate locating the position of the corner:

Established the following witnesses:

12" maple S33°E 32.67 feet (existing)
7" maple N39°E 26.59 feet (existing)
7" maple N72°W 8.05 feet (existing)
12" maple S12°W 50.29 feet (new)
Steel sign post N02°W 3.21 feet (existing)

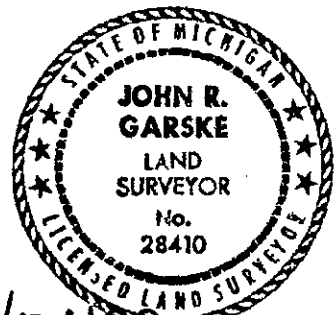

Signed by John R. Garske
Surveyor's Michigan License No. 28410

Date 8/24/99