

MAR 02 2000

SECTION

LAND CORNER RECORDATION CERTIFICATE
Filing Requirement of Act 74, Mich. P.A. 1970

Register's office }
Gogebic County } ss.

Received for record the
21st day of JULY
A. D. 1999 at 1:05 o'clock
P m., and recorded in
7 of CORNERS
on page 171
Ramona Collins Dwyer
Register of Deeds

For corners in

<u>Gogebic</u> (County)	Located In:	Corner Code #
1. Public Land Survey	Section 34T <u>45</u> NR <u>43</u> W	<u>G-11</u>
	T <u> </u> R <u> </u>	<u> </u>
	T <u> </u> R <u> </u>	<u> </u>
	T <u> </u> R <u> </u>	<u> </u>
2. Property Controlling in Section	S <u> </u> T <u> </u> R <u> </u>	<u> </u>
	S <u> </u> T <u> </u> R <u> </u>	<u> </u>
3. Miscellaneous Property in Sec.	S <u> </u> T <u> </u> R <u> </u>	<u> </u>
	S <u> </u> T <u> </u> R <u> </u>	<u> </u>

Register of Deeds Stamp & File Number

4. Lot No. _____, Recorded Plat _____
5. Private Claims _____

Section Corner to 27, 28, 33, and 34, T45N, R43W

I, John R. Garske, in a field survey on Dec. 10, 1998 do hereby state that under requirements of P.A. 74, Michigan P.A. of 1970, the corner points mentioned in lines 1 and 2 above were in conformance with regulations and rules therefore as required in the current manual of survey instructions of the United States Department of the Interior, Bureau of Land Management or by a decree of a Court of Law and/or that the corner points mentioned in lines 3, 4 and 5 above were in conformance with the rules of the Michigan Board of Land Surveyors or by a Decree of a Court of Law, established, re-established, monumented, recovered, found as expressed below:

	A	B	C	D	E	F	G	H	I	J	K	L	M
1													
2		6		5		4		3		2		1	
3													
4		7		8		9		10		11		12	
5													
6		18		17		16		15		14		13	
7													
8		19		20		21		22		23		24	
9													
10		30		29		28		27		26		25	
11													
12		31		32		33		34		35		36	
13													

NOTE: Not more than 2 corners, all in the same town and range, may be recorded on this certificate.

A. Description of original monument and accessories and/or subsequent restoration:

Original Survey by Algernon Merryweather, D.S., July 21, 1852.

Original Bearing Trees: - Sugar 8"- N55°W - 21 links
- Birch 7"- S50°E - 18 links

Corner restored in 1975 by Richard Drahn, RLS #21564, rec. L1, pg. 116. He set a 2 1/2" concrete filled pipe with a 3" dia. brass cap stamped, from which:
- 5" R. Maple- N29°W - 3.3'
- 4" Y. Birch N72°E - 29.3'
- 6" R. Maple- S28°W - 20.6'
- 7" Metal sign post- S02°W - 1.9'

B. Description of corner evidence found and/or method applied in restoring or reestablishing corner:

I found the monument and accessories as described above, all in good condition. I set nails in all the trees and recorded new ties as noted below with one new B.T. established.

(Research on file)


PEER GROUP APPROVAL
Richard L. Drahn 7/20/99
COUNTY REGISTRAR

C. Description of monument for corner and accessories established to perpetuate locating the position of the corner:

Monument found as described above, from which,

Established the following witnesses:

7" Maple	N25°W	3.43 feet (existing) (3.3')
5" Maple	S31°W	20.63 feet (existing) (20.6')
5" Y. Birch	N77°E	29.40 feet (existing) (29.3')
Steel sign rail	S10°W	1.85 feet (existing) (1.9')
8" Maple	S58°E	17.30 feet (new)

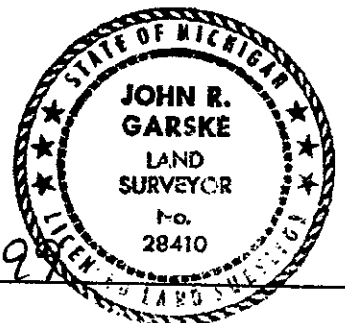

Signed by John R. Garske
Surveyor's Michigan License No. 28410

Date 7/19/99

Fed. Index V-13