

MAR 02 2000

SECTION

LAND CORNER RECORDATION CERTIFICATE  
Filing Requirement of Act 74, Mich. P.A. 1970

Register's Office }  
Gogebic County } ss.

Received for record the  
21<sup>st</sup> day of JULY  
A. D. 1999 at 1:05 o'clock  
P m., and recorded in  
Liber 7 of CORNERS  
on page 172  
Ramona Collins, Deputy  
Register of Deeds

For corners in

<u>Gogebic</u> (County)	Located In:	Corner Code #
1. Public Land Survey	Section 34 T <u>45</u> N R <u>43</u> W	<u>H-11</u>
	T ___ R ___	___
	T ___ R ___	___
	T ___ R ___	___
2. Property Controlling in Section	S ___ T ___ R ___	___
	S ___ T ___ R ___	___
3. Miscellaneous Property in Sec.	S ___ T ___ R ___	___
	S ___ T ___ R ___	___

Register of Deeds Stamp & File Number

4. Lot No. \_\_\_\_\_, Recorded Plat \_\_\_\_\_  
5. Private Claims \_\_\_\_\_

One quarter Corner Sections 27 and 34, T45N, R43W

I, John R. Garske, in a field survey on Dec. 10, 1998 do hereby state that under requirements of P.A. 74, Michigan P.A. of 1970, the corner points mentioned in lines 1 and 2 above were in conformance with regulations and rules therefore as required in the current manual of survey instructions of the United States Department of the Interior, Bureau of Land Management or by a decree of a Court of Law and/or that the corner points mentioned in lines 3, 4 and 5 above were in conformance with the rules of the Michigan Board of Land Surveyors or by a Decree of a Court of Law; established, re-established, monumented, recovered, found as expressed below:

	A	B	C	D	E	F	G	H	I	J	K	L	M
1													
2	6		5		4		3		2		1		
3													
4	7		8		9		10		11		12		
5													
6	10		17		16		15		14		13		
7													
8	19		20		21		22		23		24		
9													
10	30		29		28		27		26		25		
11													
12	31		32		33		34		35		36		
13													

NOTE: Not more than 2 corners, all in the same town and range, may be recorded on this certificate.

A. Description of original monument and accessories and/or subsequent restoration:

Original Survey by Algernon Merryweather, D.S., July 21, 1852.

Original Bearing Trees: - Spruce 5"- S5°W - 14 links  
- Tamarack 6"- N15°E - 9 links

Corner established in 1977 by Richard Drahn, RLS #21564, rec. L1, pg. 318. He set a 2 1/2" concrete filled pipe with a 3" dia. brass cap stamped, from which:

- 7" Cedar- N55°W - 18.0'
- 6" Tamarack N22°E - 25.3' (Dead)
- 4" Cedar- N71°E - 45.1'
- Steel Sign Rail- N10°W - 12.3'
- 8" Cedar- N13°E - 24.65'

B. Description of corner evidence found and/or method applied in restoring or reestablishing corner:

I found the monument and accessories as described above by Mr. Drahn and his bearing trees and accessories in good condition, except the Tamarack. I set nails in the trees and recorded new ties as noted below with one new B.T. established.


(Research on file)

PEER GROUP APPROVED  
Richard L. Drahn 7/20/99  
COUNTY REGISTER

C. Description of monument for corner and accessories established to perpetuate locating the position of the corner:

Monument found as described above, from which I  
Established the following witnesses:

10" Cedar	N48°W	17.22 feet (existing) (18.0')
10" Cedar	N12°E	24.81 feet (existing) (24.65')
5" Cedar	N75°E	44.75 feet (existing) (45.1')
Steel sign rail	N09°W	2.08 feet (existing) (2.3')
6" Ash	N43°E	16.78 feet (new)

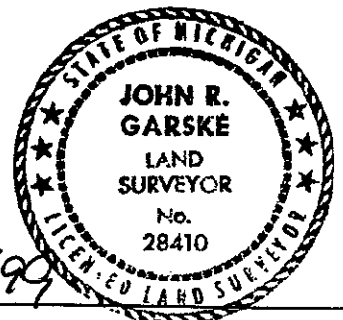

Signed by John R. Garske  
Surveyor's Michigan License No. 28410

Date 7/19/99

Fed. Index 4-15

FORM APPROVED BY MICHIGAN STATE BOARD OF PROFESSIONAL SURVEYORS, JAN. 28, 1971

REVISED MAY 14, 1975

REVISED JAN., 1983

REVISED OCT., 1995