

SURVEY & REMONUMENTATION

NOV 12 1997

COMMISSION LAND CORNER RECORDATION CERTIFICATE
 Filing Requirement of Act 74, Mich. P.A. 1970

For corners in _____ Located In: _____ Corner Code # _____
 _____ (Gogebic)

1. Public Land Survey	Section 27	T 45N	R 43W	I-10
		T _____	R _____	_____
		T _____	R _____	_____
		T _____	R _____	_____
2. Property Controlling in Section	S _____	T _____	R _____	_____
	S _____	T _____	R _____	_____
3. Miscellaneous Property in Section	S _____	T _____	R _____	_____
	S _____	T _____	R _____	_____

4. Lot No. _____, Recorded Plat _____
 5. Private Claims _____

Register's Office } ss.
 Gogebic County }

Received for record the
18th day of August
 A. D. 1997 at 11:00 o'clock
A m., and recorded in
 Liber 6 of CORNERS
 on page 177
Ramona Collins, Deputy
 Register of Deeds

Register of Deeds Stamp & File Number

One-quarter section corner common to sections 26 and 27, T45N, R43W.

I, John R. Garske, in a field survey on June 3, 1997, do hereby certify that under requirements of P.A. 74, Michigan P.A. of 1970, the corner points mentioned in lines 1 and 2 above were in conformance with regulations and rules therefore as required in the current manual of survey instructions of the United States Department of the Interior, Bureau of Land Management or by a decree of a Court of Law and/or that the corner points mentioned in lines 3, 4 and 5 above were in conformance with the rules of the Michigan Board of Professional Surveyors or by a Decree of a Court of Law; established, re-established, monumented, re-monumented, recovered, found as expressed below:

A	B	C	D	E	F	G	H	I	J	K	L	M
2	6		5		4		3		2		1	
3												
4	7		8		9		10		11		12	
5												
6	18		17		16		15		14		13	
7												
8	19		20		21		22		23		24	
9												
10	30		29		28		27	●	26		25	
11												
12	31		32		33		34		35		36	
13												

NOTE: Not more than 4 corners, all in the same town and range, may be recorded on this certificate.

A. Description of original monument and accessories and/or subsequent restoration:

Corner established by A. Merryweather, D.S., on July 18, 1852.
 Original bearing trees: Hemlock 12" N35E - 9 links
 Birch 12" S50W - 19 links

1997-Corner re-established by Richard Drahn RLS 21564 by single proportional measurement and recorded on Liber 1, page 319. He set a 2" dia. x 5' long brass capped pipe.

B. Description of corner evidence found and/or method applied in restoring or reestablishing corner:


I found the brass capped monument set by Richard Drahn in 1977. All bearing trees are in good condition, I set nails in the trees and re-measured as noted in Section C below. Also set an additional sign rail and sign.

(Record Research on File)

PEER GROUP APPROVED
Richard L. Drahn 8/13/97
COUNTY REPRESENTATIVE

C. Description of monument for corner and accessories established to perpetuate locating the position of the corner:

The following reference objects were established or updated:
 9" Spruce S24°W 33.72 ft. (existing)
 10" S. Maple S82°E 17.08 ft. (existing)
 10" W. Pine N45°W 55.67 ft. (existing)
 Steel sign post SE 2.94 ft. (existing)
 Steel sign post north 4.46 ft. (new)
 Measurements are to nails in bearing trees.

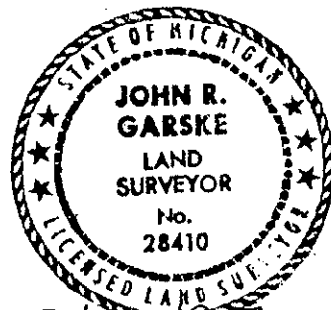

Signed by John R. Garske
 Surveyor's Michigan License No. 28410

Date 8/13/97