

SURVEY & REMONUMENTATION

NOV 12 1997

COMMISSION

LAND CORNER RECORDATION CERTIFICATE
Filing Requirement of Act 74, Mich. P.A. 1970

Register's Office }
Gogebic County } ss.

For corners in

Gogebic

(County)

Located In:

Corner Code #

Section 27, 45N, 43W

I-11

1. Public Land Survey

T___ R___
T___ R___
T___ R___
T___ R___

2. Property Controlling in Section

S___ T___ R___
S___ T___ R___

3. Miscellaneous Property in Sec.

S___ T___ R___
S___ T___ R___

Received for record the
18TH day of AUGUST
A. D. 1997 at 11:00 o'clock
A m., and recorded in
Liber 6 of CORNERS
on page 178
Ramona Collins, Deputy
Register of Deeds

Register of Deeds Stamp & File Number

4. Lot No. _____, Recorded Plat _____
5. Private Claims _____

The section corner common to sections 26, 27, 34, and 35 T45N, R43W.

I, John R. Garske, in a field survey on June 3, 197 do hereby state that under requirements of P.A. 74, Michigan P.A. of 1970, the corner points mentioned in lines 1 and 2 above were in conformance with regulations and rules therefore as required in the current manual of survey instructions of the United States Department of the Interior, Bureau of Land Management or by a decree of a Court of Law and/or that the corner points mentioned in lines 3, 4 and 5 above were in conformance with the rules of the Michigan Board of Land Surveyors or by a Decree of a Court of Law; established, re-established, monumented, recovered, found as expressed below:

NOTE: Not more than 2 corners, all in the same town and range, may be recorded on this certificate.

A	B	C	D	E	F	G	H	I	J	K	L	M
1												
2	6		5		4		3		2		1	
3												
4	7		8		9		10		11		12	
5												
6	18		17		16		15		14		13	
7												
8	19		20		21		22		23		24	
9												
10	30		29		28		27		26		25	
11								●				
12	31		32		33		34		35		36	
13												

A. Description of original monument and accessories and/or subsequent restoration:

On July 18, 1852 A. Merryweather, D.S., established the corner and the following bearing trees:
Hemlock 16" N60°E - 25 links
Hemlock 12" S70°E - 20 links

1975-Richard Drahn, RLS 21564 set the corner just into a pond from recovered remains of the bearing trees. He recorded the corner in Liber 1, page 117.

B. Description of corner evidence found and/or method applied in restoring or reestablishing corner:


I found a 3/4" galvanized pipe at the corner location in a wet floating bog area. A brass capped pipe reference monument is 21.52' due west as noted by Richard Drahn. His two bearing trees are in good condition. I set nails in the trees and re-measured and established one new bearing tree as noted in Section C below. I also set a 3 1/4" dia. stamped aluminum cap on the found 3/4" iron pipe.

DEER GROUP APPROVED
Richard L. Drahn 8/13/97
COUNTY REPRESENTATIVE

(Record Research on File)

C. Description of monument for corner and accessories established to perpetuate locating the position of the corner:

I established or updated the following reference objects:
Steel sign rail south 2.18 ft. (existing)
8" Spruce N01°W 42.10 ft. (existing)
12" Cedar S88°E 14.44 ft. (existing)
4" Tamarack S80°W 11.24 ft. (new)
Reference monument east 21.52 ft.
Steel sign rail east 0.40 ft. (from R.M.)
Measurements are to nails in bearing trees.

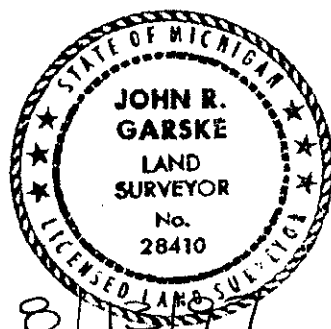

Signed by John R. Garske
Surveyor's Michigan License No. 28410

Date 8/13/97