

**SURVEY & REMONUMENTATION**

NOV 12 1997

COMMISSION

**LAND CORNER RECORDATION CERTIFICATE**  
Filing Requirement of Act 74, Mich. P.A. 1970

Register's Office }  
Gogebic County } ss.

Received for record the  
9<sup>TH</sup> day of OCTOBER  
A. D. 1997 at 11:00 o'clock  
A m., and recorded in  
Liber 6 of CORNERS  
on page 232.

*Ramona Collins, Deputy*  
Register of Deeds

Register of Deeds Stamp & File Number

For corners in

Gogebic (County)	Located In:	Corner Code #
1. Public Land Survey	Section 26, 45N, 43W	K-10
	T ___ R ___	_____
	T ___ R ___	_____
	T ___ R ___	_____
	T ___ R ___	_____
2. Property Controlling in Section	S ___ T ___ R ___	_____
	S ___ T ___ R ___	_____
3. Miscellaneous Property in Sec.	S ___ T ___ R ___	_____
	S ___ T ___ R ___	_____

4. Lot No. \_\_\_\_\_, Recorded Plat \_\_\_\_\_  
5. Private Claims \_\_\_\_\_

1/4 corner sections 25 and 26, T45N, R43W

I, John R. Garske, in a field survey on June/Aug 19 97 hereby state that under requirements of P.A. 74, Michigan P.A. of 1970, the corner points mentioned in lines 1 and 2 above were in conformance with regulations and rules therefore as required in the current manual of survey instructions of the United States Department of the Interior, Bureau of Land Management or by a decree of a Court of Law and /or that the corner points mentioned in lines 3, 4 and 5 above were in conformance with the rules of the Michigan Board of Land Surveyors or by a Decree of a Court of Law; established, re-established, monumented, recovered, found as expressed below:

NOTE: Not more than 2 corners, all in the same town and range, may be recorded on this certificate.

	A	B	C	D	E	F	G	H	I	J	K	L	M
1													
2	6		5		4		3		2		1		
3													
4	7		8		9		10		11		12		
5													
6	18		17		16		15		14		13		
7													
8	19		20		21		22		23		24		
9													
10	30		29		28		27		26		25		
11													
12	31		32		33		34		35		36		
13													

A. Description of original monument and accessories and/or subsequent restoration:

Original survey by Algernon Merryweather, D.S. in 1852  
Original BT's:  
Balsam 4" @ corner  
Birch 8" - N45°W - 8 links

B. Description of corner evidence found and/or method applied in restoring or reestablishing corner:

**PEER GROUP APPROVED**  
*Richard L. Dean 10/8/97*  
**COUNTY**

No evidence of the original corner could be found.


I set the corner by single proportional measurement on line an one half the distance between opposing section corners in accordance with the original government notes.

(Research on file)

C. Description of monument for corner and accessories established to perpetuate locating the position of the corner:

I set a 2 1/2" x 30" alum. monument with a 3 1/4" dia. alum. cap stamped to identify the corner, from which I established:

10" Red Pine	N66°W	4.96 feet
12" Red Pine	N41°E	21.21 feet
12" Red Pine	S47°E	2.95 feet
Steel sign rail	S50°W	1.83 feet

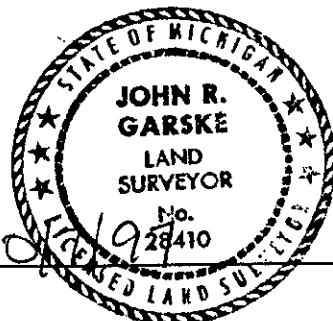

Signed by John R Garske  
Surveyor's Michigan License No. 28410

Date 10/8/97