

MAR 02 2000

SECTION

LAND CORNER RECORDATION CERTIFICATE
Filing Requirement of Act 74, Mich. P.A. 1970

Register's Office }
Gogebic County } ss.

For corners in

Gogebic
(County)

Located In:

Corner Code #

1. Public Land Survey

T46NR 43W L-13

2. Property Controlling in Section

T45NR 43W L-1

3. Miscellaneous Property in Sec.

S T R
S T R
S T R
S T R

Received for record the
12 day of MAY
A. D. 1999 at 10:30 o'clock
A M., and recorded in
Liber 7 of CORNERS
on page 134
Raymond Collins, Deputy
Register of Deeds

Register of Deeds Stamp & File Number

4. Lot No. _____, Recorded Plat _____
5. Private Claims _____

Quarter Corner 36 & 1; T.45-46 N., R.43 W.

Richard L. Drahn in a field survey on April 20 19 99 do hereby state that under requirements of P.A. 74, Michigan P.A. of 1970, the corner points mentioned in lines 1 and 2 above were in conformance with regulations and rules therefore as required in the current manual of survey instructions of the United States Department of the Interior, Bureau of Land Management or by a decree of a Court of Law and /or that the corner points mentioned in lines 3, 4 and 5 above were in conformance with the rules of the Michigan Board of Land Surveyors or by a Decree of a Court of Law; established, re-established, monumented, recovered, found as expressed below:

NOTE: Not more than 2 corners, all in the same town and range, may be recorded on this certificate.

	A	B	C	D	E	F	G	H	I	J	K	L	M
1													
2	6	5	4	3	2	1							
3													
4	7	8	9	10	11	12							
5													
6	19	17	16	15	14	13							
7													
8	19	20	21	22	23	24							
9													
10	30	29	28	27	26	25							
11													
12	31	32	33	34	35	36							
13													

A. Description of original monument and accessories and/or subsequent restoration:

Corner established by Austin Burt on 8/5/1847. Original B.T.s --- Y. Birch 18" N.39 E. 50 links (33.00') --- Sugar Maple 12" N.20 W. 37 links (24.42')

Corner position restored by Donald D. Lappala, RLS 12585 on 9/23/69 from the remains of the two original B.T.s He set a 2" X 5' iron pipe with a 3" stamped brass cap and the following new B.T.s: --- 7" Sugar Maple S.35 E. 20.3' --- 14" Cedar S.24 W. 26.7' --- 14" Yellow Birch West 19.5' ---

Corner recorded in Gogebic County USFS Liber, Page A-23 on 4/8/70.

B. Description of corner evidence found and/or method applied in restoring or reestablishing corner:

Recovered the monument as described and the bearing trees as follows:
8" Sugar Maple S.35 E. dead and down
15" Cedar S.28 W. 26.73' (new nail)
20" Yellow Birch S.88 W. 19.28' (new nail)

The 1st original B.T. is now a downed 36" Y. Birch with GLO blazes. The second one is now a large Sugar Maple stump decayed to ground line.


Corner research on file with Gogebic County records.

Richard L. Drahn 5/11/99
REGISTERED LAND SURVEYOR

C. Description of monument for corner and accessories established to perpetuate locating the position of the corner.

New bearing objects referenced:

11" Red Maple S.63 E. 29.21'
6" Sugar Maple N.09 W. 20.05'
6' Steel sign rail S.33 W. 2.09'
4"X4"X7' Cedar sign post N.03 W. 2.95'

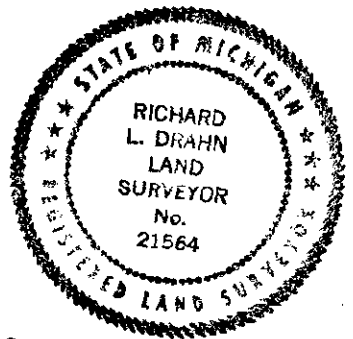

Signed by Richard L. Drahn
Surveyor's Michigan License No. 21564

Date May 2, 1999

USFS A-23