



JAN 20 1999


LAND CORNER MONUMENTS

SECTION

T. 45 N., R. 43 W.

MARNISCO TOWNSHIP

State Index

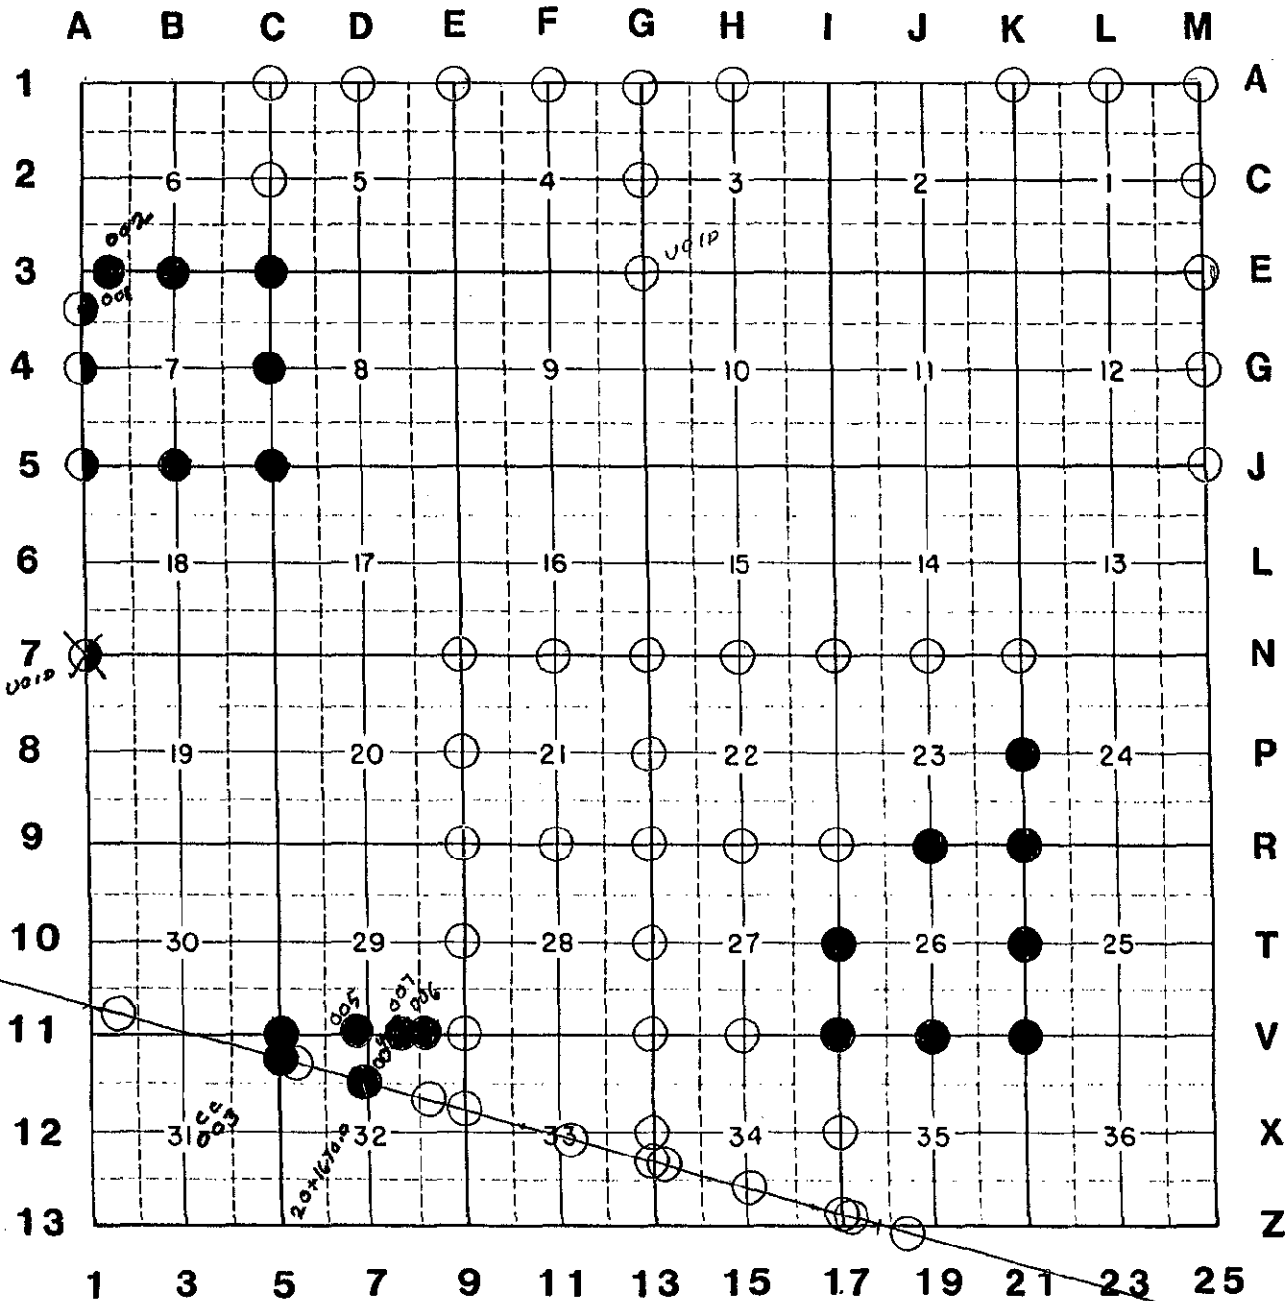

Federal Index

AS OF 12/31/98

LEGEND

- GLO Corners researched
- ⊙ GLO Corners monumented, not approved
- ⊗ GLO Corners approved
- GLO Corners approved & reported to State

T. 45 N., R. 43 W.