

LAND CORNER RECORDATION CERTIFICATE

FILING REQUIREMENT OF ACT 74, MICH. P.A.1970
GOGEBIC COUNTY

FOR CORNERS OF--:	LOCATED IN--:	CORNER CODE NUMBER
1. PUBLIC LAND SURVEY _____	T. <u>45</u> ^{N.} / _{X.} , R. <u>44</u> ^{X.} / _{W.}	A-3
2. PROPERTY CONTROLLING IN SECTION _____	, T. _____ ^{N.} / _{S.} , R. _____ ^{E.} / _{W.}	_____
3. MISCELLANEOUS PROPERTY IN SECTION _____	, T. _____ ^{N.} / _{S.} , R. _____ ^{E.} / _{W.}	_____
4. LOT NO. _____, RECORDED PLAT _____	PEER GROUP Approved	
5. PRIVATE CLAIMS _____	<u>Richard L. Drahn</u> <u>1/20/94</u>	

Register's Office } ss.
Gogebic County }

Received for record the
5TH day of JANUARY
A. D. 1994 at 10:05 o'clock
A m., and recorded in
Liber 4 of CORNERS
on page 344
Betty Laine Deputy
Register of Deeds

REGISTER OF DEEDS STAMP AND FILING NUMBER

Section corner 6, 7, 1 and 12; T.45N., R.44-45W.

I, Richard L. Drahn do hereby certify that under requirements of P.A. 74, Michigan P.A. of 1970, the corner points mentioned in lines 1 and 2 above (identified with circles on index code diagram - over) were, in a field survey on April 29 1993, established, re-established, monumented, re-monumented, recovered or restored as expressed below and in conformance with regulations and rules therefore as required in the current manual of survey instructions of the United States Department of the Interior, Bureau of Land Management or by a decree of a court of law. Furthermore, that the corner points mentioned in lines 3, 4 and 5 above were, in a field survey on _____ 19____, found, recovered, restored, established or re-established as expressed below and in conformance with the rules of the Michigan State Board of Registration for Land Surveyors or, by a Decree of a Court of law:

A. Description of original monument and accessories and/or subsequent restoration:
Original corner established by Austin Burt, U.S. Deputy Surveyor on August 28, 1847.
Original bearing trees:

Sugar	12"	S.51°E.	10 links	(6.60 feet)
Y. Birch	14"	N.56°W.	51 links	(33.66 feet)
Y. Birch	6"	S.47°W.	20 links	(13.20 feet)
Hemlock	12"	N.38°E.	13 links	(8.58 feet)

C. E. Lumpert, Timber Cruiser, on 8/13/35 recovered the SE B.T. still scribed. He placed a location poster on a 20" hemlock 12 paces east of the corner.

B. Description of corner evidence found and/or method applied in restoring or re-establishing corner:
Restored corner at record bearing and distance from the following remains of the original bearing trees.

1. Flakes of sugar maple wood from dead in place 18-20" sugar maple.
2. Downed 18-22" badly decayed yellow birch.
3. Wind thrown stump hole with fragments of yellow birch bark.
4. Badly decayed 18-24" downed hemlock.

C. E. Lumpert's tag tree is now a cut and badly decayed 20-24" hemlock stump bearing S. 73°E., 30.2 feet from the original corner position.

C. Description of monument for corner and accessories established to perpetuate locating the position of the corner:
At the corner position I set a standard 2 1/2" diameter by 30" long split base aluminum monument with a 3" cast aluminum cap, stamped to read: T.45N., R.44-45W.; S-6, S-7, S-1, S-12; 1993; R.L.S. 21564. From which I have established the following new blazed and scribed bearing trees:

9"	Sugar Maple	N.52°W.	17.68 feet
6"	Sugar Maple	S.52°E.	20.93 feet
11"	Sugar Maple	S.75°W.	39.18 feet
6'	Steel rail	North	1.71 feet


SIGNED BY _____ DATE _____

SURVEYOR'S MICHIGAN REGISTRATION NO. _____

FOR STATE AND UNITED STATES AGENCIES:

SIGNED BY _____ DATE _____

APPROVED AND SIGNED BY Richard L. Drahn DATE December 22, 1993
MICHIGAN REGISTERED LAND SURVEYOR

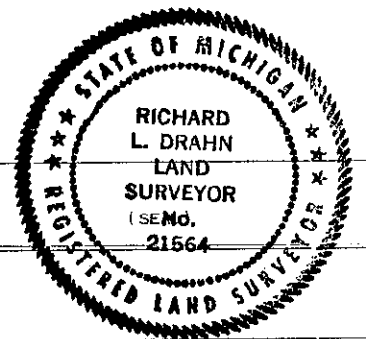

FED E-1

SURVEYOR'S MICHIGAN REGISTRATION NO. 21564