

LAND CORNER RECORDATION CERTIFICATE

FILING REQUIREMENT OF ACT 74, MICH. P.A.1970

GOGEBIC COUNTY

FOR CORNERS OF—: 1. PUBLIC LAND SURVEY _____ 2. PROPERTY CONTROLLING IN SECTION _____ 3. MISCELLANEOUS PROPERTY IN SECTION _____ 4. LOT NO. _____, RECORDED PLAT _____ 5. PRIVATE CLAIMS _____ Section corner 7, 18, 12 and 13; T.45N., R.44-45W.	LOCATED IN—: T. 45 N. R. 44 IX S. R. E. W. T. _____ N. R. _____ E. W. T. _____ N. R. _____ E. W. PEER GROUP RECORDED PLAT _____ Richard L. Drahn 1/20/94	CORNER CODE NUMBER A-5 _____ _____ Approved _____ _____
--	---	---

Register's Office }
 Gogebic County } ss.
 Received for record the
 5TH day of JANUARY
 A. D. 1994 at 10:05 o'clock
 A. m., and recorded in
 Liber 4 of CORNERS
 on page 346
 Betty Lassin Deputy
 Register of Deeds
 REGISTER OF DEEDS STAMP AND
 FILING NUMBER

I, Richard L. Drahn do hereby certify that under requirements of P.A. 74, Michigan P.A. of 1970, the corner points mentioned in lines 1 and 2 above (identified with circles on index code diagram—over) were, in a field survey on May 25 1993, established, re-established, monumented, re-monumented, recovered or restored as expressed below and in conformance with regulations and rules therefore as required in the current manual of survey instructions of the United States Department of the Interior, Bureau of Land Management or by a decree of a court of law. Furthermore, that the corner points mentioned in lines 3, 4 and 5 above were, in a field survey on _____ 19____, found, recovered, restored, established or re-established as expressed below and in conformance with the rules of the Michigan State Board of Registration for Land Surveyors or, by a Decree of a Court of law:

- A. Description of original monument and accessories and/or subsequent restoration:
 Original corner established by Austin Burt, U.S. Deputy Surveyor on August 28, 1847.
 Original bearing trees:
- | | | | | |
|---------|-----|-------------|----------|--------------|
| Sugar | 12" | S.46°E. | 20 links | (13.20 feet) |
| Sugar | 16" | N.21°W. | 50 links | (33.00 feet) |
| Sugar | 10" | S.21°W. | 32 links | (21.12 feet) |
| Hemlock | 12" | N.13 1/2°E. | 79 links | (52.14 feet) |

John Erickson, Timber Cruiser, recovered the hemlock bearing tree still scribed on 8/01/35. He placed a location poster on a 10" hemlock 1/2 chain north of the corner.

- B. Description of corner evidence found and/or method applied in restoring or re-establishing corner:
 Area heavily disturbed by logging, road and skid road construction. No evidence of the original corner or of the 1935 reference tag remains. Corner position re-established by proportionate measure on line between the section corner of Sections 6, 7, 1 and 12 and the closing corner of 19 and 24 on the Michigan-Wisconsin State Line. U.S.F.S. Location Poster by Bolen and Long dated 5/1/79 on 10" dead sugar bears; S.62°E., 48.8 feet. Four-inch square cedar post bears S.64°E., 51.6 feet. (Paced in from approximately C.C. on State Line by Dick Bolen.)

- C. Description of monument for corner and accessories established to perpetuate locating the position of the corner:
 At the corner position I set a standard 2 1/2" diameter by 30" long split base aluminum monument with a 3" cast aluminum cap, stamped to read: T.45N., R.44-45W.; S-7, S-18, S-12, S-13; 1993; R.L.S. 21564. From which I have established the following new blazed and scribed bearing trees:
- | | | | |
|----|-------------|---------|------------|
| 9" | Sugar Maple | N.03°W. | 33.18 feet |
| 9" | Sugar Maple | N.66°E. | 13.06 feet |
| 9" | Sugar Maple | S.42°E. | 23.42 feet |
| 6' | Steel rail | N.64°W. | 1.77 feet |


SIGNED BY _____ DATE _____

SURVEYOR'S MICHIGAN REGISTRATION NO. _____

FOR STATE AND UNITED STATES AGENCIES:

SIGNED BY _____ DATE _____

APPROVED AND SIGNED BY Richard L. Drahn DATE December 22, 1993
CHIEF OF SURVEY PARTY
MICHIGAN REGISTERED LAND SURVEYOR

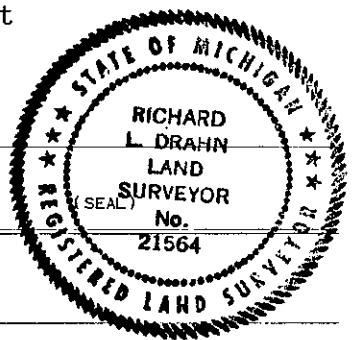

FED J-1

SURVEYOR'S MICHIGAN REGISTRATION NO. 21564