MAR 0 2 2000

LAND CORNER RECORDATION CERTIFICATE

Filing Requirement of Act 74, Mich. P.A. 1970

Register's Office } ss.
Gogebic County }

Received for record the 12th day of MAY A. D. 19 99 at 11:00 o'clock A m., and recorded in Liber 7 of CORNERS on page 96.

Ramona Collins Dep.
Register of Deeds

Register of Deeds Stamp & File Number

For corners in SECTION
Gogebic (County)

	Located In:	Corner Code ##
1. Public Land Survey	T45N R 45W	A-2
	T ___ R ___	
	T ___ R ___	
	T45N R 46W	M-2
2. Property Controlling	S ___ T ___ R ___	
in Section	S ___ T ___ R ___	
3. Miscellaneous	S ___ T ___ R ___	
Property in Sec.	S ___ T ___ R ___	

4. Lot No. _____ , Recorded Plat _____
5. Private Claims _____

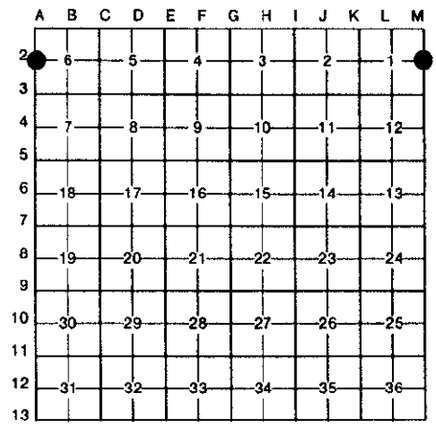

¼ Corner 1 & 6; T.45 N., R.45-46 W

Richard L. Drahn, in a field survey on March 17, 19 99, do hereby certify that under requirements of P.A. 74, Michigan P.A. of 1970, the corner points mentioned in lines 1 and 2 above were in conformance with regulations and rules therefore as required in the current manual of survey instructions of the United States Department of the Interior, Bureau of Land Management or by a decree of a Court of Law and/or that the corner points mentioned in lines 3, 4 and 5 above were in conformance with the rules of the Michigan Board of Land Surveyors or by a Decree of a Court of Law; established, re-established, monumented, re-monumented, recovered, found as expressed below:

NOTE: Not more than 4 corners, all in the same town and range, may be recorded on this certificate.

A. Description of original monument and accessories and/or subsequent restoration:

Corner established by John Burt on 8/30/1847. Original B.T.s --- Y. Birch 22" N.45 W. 3 links (1.98') --- Fir 8" S.72 E. 22 links (14.52') ---

C.E. Limpert in 1935 recovered a squared 5" Sugar marking the approximate corner and placed a location poster on the West side of a 20" Hemlock.

B. Description of corner evidence found and/or method applied in restoring or reestablishing corner:

Restored the corner position at record bearing and distance from the remains of the two original B.T.s. The first is a very large series of root holes with fragments of wood and Yellow Birch bark. The second one is now a shallow depression.
The 2.00 chain distance south to "enter swamp" and the 2.00 chain distance north to "top of ridge" are in accordance with the original field notes.
No evidence found of the 1935 squared sugar or Hemlock tag tree.
17" squared Hemlock bears N.15 E. 96 feet. A 10" Squared Cedar bears N.18 E. 89 feet.

Corner research form on file with Gogebic County records.

C. Description of monument for corner and accessories established to perpetuate locating the position of the corner:

At the corner position I set a 2" X 30" aluminum pipe with a 3¼" stamped aluminum cap and the following new bearing objects.

8"	Sugar Maple	N.31 E.	9.23'
7"	Sugar Maple	S.39 W.	27.22'
7"	Sugar Maple	S.56 E.	17.84'
6'	Steel sign rail	N.61 W.	1.81'

PEER GROUP APPROVED
Richard L. Drahn 5/11/99
COUNTY REPRESENTATIVE

STATE OF MICHIGAN
RICHARD L. DRAHN LAND SURVEYOR No. 21564
REGISTERED LAND SURVEYOR

Signed by Richard L. Drahn Date March 19, 1999

Surveyor's Michigan License No. 21564

USFS C-25

FORM APPROVED BY MICHIGAN STATE BOARD OF LAND SURVEYORS, JAN. 28, 1971
REVISED MAY 14, 1975
REVISED JAN., 1983