SURVEY & REMONUMENTATION

AUG 0 8 1997

COMMISSION

LAND CORNER RECORDATION CERTIFICATE

Filing Requirement of Act 74, Mich. P.A. 1970

Register's Office } ss.
Gogebic County }

Received for record the 13TH day of MAY A. D. 1997 at 1:55 o'clock P m., and recorded in Liber 6 of CORNERS on page 108.

Ramona Collins, Deputy
Register of Deeds

Register of Deeds Stamp & File Number

For corners in

Gogebic (County)

	Located In:	Corner Code #
1. Public Land Survey	T 45N R 45W	E-1
	T ___ R ___	
	T 46N R 45W	E-13
	T ___ R ___	
2. Property Controlling	S ___ T ___ R ___	
in Section	S ___ T ___ R ___	
3. Miscellaneous	S ___ T ___ R ___	
Property in Sec.	S ___ T ___ R ___	

4. Lot No. _____, Recorded Plat _____
5. Private Claims _____

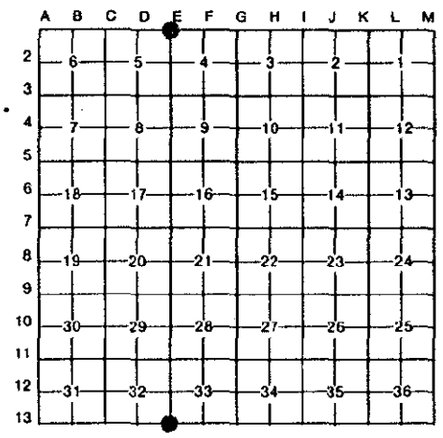

Section Corner, sec's 4, 5, 32 & 33; T.45-46 N., R.45 W.

I, Richard L. Drahn in a field survey on May 3, 19 97, do hereby certify that under requirements of P.A. 74, Michigan P.A. of 1970, the corner points mentioned in lines 1 and 2 above were in conformance with regulations and rules therefore as required in the current manual of survey instructions of the United States Department of the Interior, Bureau of Land Management or by a decree of a Court of Law and/or that the corner points mentioned in lines 3, 4 and 5 above were in conformance with the rules of the Michigan Board of Land Surveyors or by a Decree of a Court of Law; established, re-established, monumented, re-monumented, recovered, found as expressed below:

NOTE: Not more than 4 corners, all in the same town and range, may be recorded on this certificate.

A. Description of original monument and accessories and/or subsequent restoration:

Corner established by John Burt, in August 1847. Original B.T.s --- 22" Y. Birch N.50 E. 31 links (20.46') --- Hemlock 24" N.28 W. 27 links (17.82') --- Lynn 12" S.33 W. 15 links (9.90') --- Sugar 14" S.13 E. 32 lks. (21.12')

Bill Stuth, Wisc. RLS, in 1984 recovered the remains of the Y. Birch and the Hemlock B.T.s. On 11/13/84, R. Drahn (21564) and J. Goss (23509) recovered the same decayed remains and the stump hole of the Lynn B.T. They set a 2" X 30" alum. monument with a 3¼" stamped aluminum cap and new B.T.s --- 6" Sugar Maple (6" broken stub) S.37 E. (S.36 E.) 4.40' (4.32') --- 12" (13") Sugar Maple N.16 E. (N.21 E.) 20.57' (20.31' new nail) --- 10" Sugar Maple

B. Description of corner evidence found and/or method applied in restoring or reestablishing corner:

N.67 W. (N.64 W.) 21.95 (21.97') --- 6' Steel sign rail N.10 W. (N.09 W.) 2.0 ' ---

Corner recorded in Gogebic County records in Liber 2, Page 611 on 12/6/84.

Corner position found marked by the monument as described and the 1984 B.T.s as indicated in parentheses above. The remains of the first three 1847 B.T.s are still evident.

Research form on file with Gogebic County records.

C. Description of monument for corner and accessories established to perpetuate locating the position of the corner:

From the above described monument I established a new B.T.:

9" Sugar Maple S.04 E. 28.07'

PEER GROUP APPROVED
Richard L. Drahn 5/12/97
COUNTY REPRESENTATIVE

STATE OF MICHIGAN
RICHARD L. DRAHN
LAND SURVEYOR
No. 21564
REGISTERED LAND

Signed by Richard L. Drahn Date May 9, 1997

Surveyor's Michigan License No. 21564

USFS A-9, Z-9

108

FORM APPROVED BY MICHIGAN STATE BOARD OF LAND SURVEYORS, JAN. 28, 1971
REVISED MAY 14, 1975
REVISED JAN., 1983