

**SURVEY & REMONUMENTATION**

AUG 08 1997

**LAND CORNER RECORDATION CERTIFICATE**  
Filing Requirement of Act 74, Mich. P.A. 1970

Register's Office }  
Gogebic County } ss.

For corners in **COMMISSION**

Received for record the  
13<sup>th</sup> day of MAY  
A. D. 1997 at 1:55 o'clock  
P m., and recorded in  
Liber 6 of CORNERS

|                                    |                           |               |
|------------------------------------|---------------------------|---------------|
| <u>Gogebic</u><br>(County)         | Located In:               | Corner Code # |
| 1. Public Land Survey              | T <u>45N</u> R <u>45W</u> | <u>G-1</u>    |
|                                    | T <u>46N</u> R <u>45W</u> | <u>G-13</u>   |
| 2. Property Controlling in Section | S ___ T ___ R ___         |               |
| 3. Miscellaneous Property in Sec.  | S ___ T ___ R ___         |               |

on page 109  
Ramona Collins, Deputy  
Register of Deeds

Register of Deeds Stamp & File Number

4. Lot No. \_\_\_\_\_, Recorded Plat \_\_\_\_\_  
5. Private Claims \_\_\_\_\_

|    |    |    |    |    |    |    |   |   |   |   |   |   |
|----|----|----|----|----|----|----|---|---|---|---|---|---|
| A  | B  | C  | D  | E  | F  | G  | H | I | J | K | L | M |
| 2  | 6  | 5  | 4  | 3  | 2  | 1  |   |   |   |   |   |   |
| 3  |    |    |    |    |    |    |   |   |   |   |   |   |
| 4  | 7  | 8  | 9  | 10 | 11 | 12 |   |   |   |   |   |   |
| 5  |    |    |    |    |    |    |   |   |   |   |   |   |
| 6  | 18 | 17 | 16 | 15 | 14 | 13 |   |   |   |   |   |   |
| 7  |    |    |    |    |    |    |   |   |   |   |   |   |
| 8  | 19 | 20 | 21 | 22 | 23 | 24 |   |   |   |   |   |   |
| 9  |    |    |    |    |    |    |   |   |   |   |   |   |
| 10 | 30 | 29 | 28 | 27 | 26 | 25 |   |   |   |   |   |   |
| 11 |    |    |    |    |    |    |   |   |   |   |   |   |
| 12 | 31 | 32 | 33 | 34 | 35 | 36 |   |   |   |   |   |   |
| 13 |    |    |    |    |    |    |   |   |   |   |   |   |

Section Corner sec's 3, 4, 33 & 34; T.45-46 N., R.45 W.

I, Richard L. Drahn in a field survey on May 6, 19 97, do hereby certify that under requirements of P.A. 74, Michigan P.A. of 1970, the corner points mentioned in lines 1 and 2 above were in conformance with regulations and rules therefore as required in the current manual of survey instructions of the United States Department of the Interior, Bureau of Land Management or by a decree of a Court of Law and/or that the corner points mentioned in lines 3, 4 and 5 above were in conformance with the rules of the Michigan Board of Land Surveyors or by a Decree of a Court of Law; established, re-established, monumented, re-monumented, recovered, found as expressed below:

**NOTE: Not more than 4 corners, all in the same town and range, may be recorded on this certificate.**

**A. Description of original monument and accessories and/or subsequent restoration:**

Corner established by John Burt in August, 1847. Original B.T.s --- 8" Black Ash N.53 E. 56 links (36.96') --- Y. Birch 16" N.62 W. 15 links (9.90') --- Y. Birch S.35 E. 33 links (21.78') --- Hemlock 8" S.65 W. 31 links (20.46') ---

In 1984 Bill Stuth, Wisc. RLS recovered the SE B.T. still scribed. On 10/8/86 John Goss (23509) restored the corner position from the remains of the last three B.T.s He set a 1½" X 36" iron pipe with a 2" stamped brass cap and the following new B.T.s --- 23" (10") Balsam S.14 E. (S.07 E.)

**B. Description of corner evidence found and/or method applied in restoring or reestablishing corner:**

19.6' (20.28' nail in side) --- 31" (8" dead & down) Balsam N.86 E. (S.73 E.)  
18.4' (18.87' nail in side).--- Corner recorded in Liber 3, Page 2 of Gogebic County records on 12/10/86.

Corner position found marked by the monument as described and the 1986 B.T.s as indicated in parentheses above. Remnants of the three 1847 B.T.s are still evident. The Y. Birch at S.35 E. is now a live 30" Y. Birch with GLO blazes although the scribing is no longer visible.


Research form on file with Gogebic County records.

**PEER GROUP APPROVED**  
Richard L. Drahn 5/12/97  
COUNTY REPRESENTATIVE

**C. Description of monument for corner and accessories established to perpetuate locating the position of the corner:**

From the above described monument I established the following:

|    |                 |         |        |
|----|-----------------|---------|--------|
| 7" | Yellow Birch    | N.26 W. | 32.27' |
| 6" | Sugar Maple     | S.46 W. | 26.61' |
| 5" | Red Maple       | S.77 E. | 32.72' |
| 6' | Steel sign rail | N.42 E. | 1.75'  |

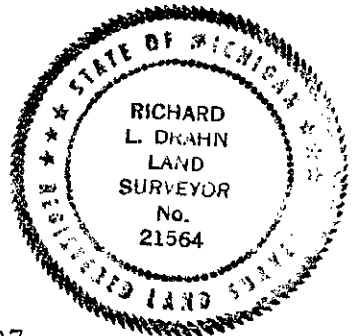

Signed by Richard L. Drahn Date May 9, 1997

Surveyor's Michigan License No. 21564