

OCT 03 1996

COMMISSION

LAND CORNER RECORDATION CERTIFICATE
Filing Requirement of Act 74, Mich. P.A. 1970

For corners in _____ Located In: _____ Corner Code # _____

1. Public Land Survey T 45N R 45W G-5
 T _____ R _____
 T _____ R _____
 T _____ R _____

2. Property Controlling in Section S _____ T _____ R _____
 S _____ T _____ R _____

3. Miscellaneous Property in Section S _____ T _____ R _____
 S _____ T _____ R _____


Register's Office }
Gogebic County } ss.

Received for record the
16th day of AUGUST
 A. D. 1996 at 10:45 o'clock
A m., and recorded in
 Libr. 6 of CORNERS
 on page 1
Ramona Collins, Deputy
 Register of Deeds

Register of Deeds Stamp & File Number

4. Lot No. _____, Recorded Plat _____
5. Private Claims _____
 Section Corner common to sections 9, 10, 15, & 16, T45N, R45W.

I, John R. Garske, in a field survey on July 10, 1996, do hereby certify that under requirements of P.A. 74, Michigan P.A. of 1970, the corner points mentioned in lines 1 and 2 above were in conformance with regulations and rules therefore as required in the current manual of survey instructions of the United States Department of the Interior, Bureau of Land Management or by a decree of a Court of Law and/or that the corner points mentioned in lines 3, 4 and 5 above were in conformance with the rules of the Michigan Board of Professional Surveyors or by a Decree of a Court of Law; established, re-established, monumented, re-monumented, recovered, found as expressed below:

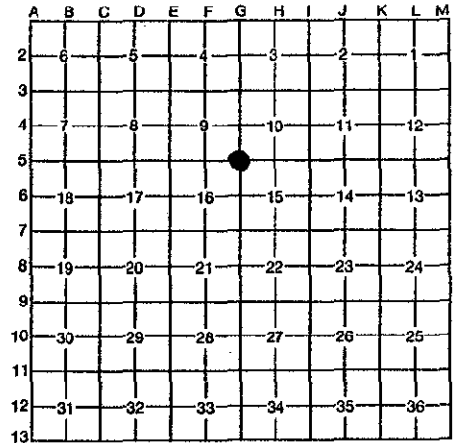

NOTE: Not more than 4 corners, all in the same town and range, may be recorded on this certificate.

A. Description of original monument and accessories and/or subsequent restoration:

- In August 7, 1851, Austin Burt, U.S. Deputy surveyor performed the original township subdivision and set a wooden post with the following bearing trees: Cedar 8"-S43°E-33 links, Cedar 14"-N10°W-32 links..
- Corner recorded by John Garske, L3, pg 256 in 1988. He set a 1 1/2" x 3" iron pipe with a stamped brass cap.
 Ties: 4" maple - N24°W - 10.90 feet
 4" maple - S78°E - 15.29 feet
 12" Y. birch - S42°W - 18.53 feet

B. Description of corner evidence found and/or method applied in restoring or reestablishing corner:

I found a 1 3/4" iron pipe with a 2" brass cap stamped: T45N, R45W, 9, 10, 15, 16, R.L.S. 28410. I also found the 3 bearing trees with blazes as noted above in good condition.


P.A. 74 Research on file.

PEER GROUP APPROVED
Richard P. Deahn 8/14/96
COUNTY REPRESENTATIVE

C. Description of monument for corner and accessories established to perpetuate locating the position of the corner:

I accepted the above monument and established new bearing trees and/or reference objects:

- 6" Maple - N24°W - 10.95 feet (existing)
- 6" Maple - S78°E - 15.40 feet (existing)
- 12" Yellow Birch - S42°W - 18.53 feet (existing)
- 6" Steel rail with sign - S87°E - 1.37 feet
- I also stamped a 1996 on the cap.

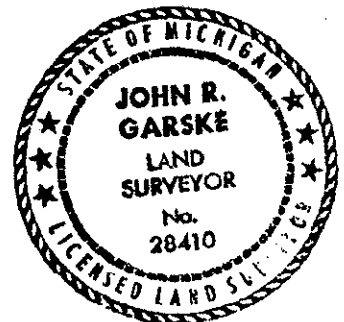

Signed by John R. Garske Date 8-4-96
 Surveyor's Michigan License No. 28410