

SURVEY & REMONUMENTATION

AUG 08 1997

COMMISSION

LAND CORNER RECORDATION CERTIFICATE
Filing Requirement of Act 74, Mich. P.A. 1970

Register's Office }
Gogebic County } ss.

Received for record the
13TH day of MAY

A. D. 1997 at 1:55 o'clock

P m., and recorded in
Liber 6 of CORNERS

on page 110
Ramona Collins, Deputy
Register of Deeds

For corners in

Gogebic
(County)

Located In:

Corner Code #

1. Public Land Survey

T 45N R 45W H-1

T _____ R _____

T 46N R 45W H-13

T _____ R _____

2. Property Controlling
in Section

S _____ T _____ R _____
S _____ T _____ R _____

3. Miscellaneous
Property in Sec.

S _____ T _____ R _____
S _____ T _____ R _____

Register of Deeds Stamp & File Number

4. Lot No. _____, Recorded Plat _____

5. Private Claims _____

Quarter corner 3 & 34; T.45-46 N., R.45 W.

I, Richard L. Drahn in a field survey on May 6, 1997
do hereby certify that under requirements of P.A. 74, Michigan P.A. of 1970, the corner points mentioned
in lines 1 and 2 above were in conformance with regulations and rules therefore as required in the
current manual of survey instructions of the United States Department of the Interior, Bureau of Land
Management or by a decree of a Court of Law and/or that the corner points mentioned in lines 3, 4 and 5
above were in conformance with the rules of the Michigan Board of Land Surveyors or by a Decree of a
Court of Law; established, re-established, monumented, re-monumented, recovered, found as
expressed below:

**NOTE: Not more than 4 corners, all in the same town and range, may be recorded
on this certificate.**

A. Description of original monument and accessories and/or subsequent restoration:

Corner established by John Burt in August, 1847. Original B.T.s --- Cedar
6" N.68 E. 31 links (20.46') --- Cedar 22" N.59 W. 33 links (21.78') ---

Bill Stuth, Wisc. RLS recovered the original post and the remains of the
two original B.T.s in 1984. John Goss (23509) on 10/8/86 recovered the
remains of the two GLO B.T.s and monumented the corner with a 1½" X 36"
iron pipe with a 2" stamped brass cap and established the following new
bearing trees. --- 13" Black Ash N70 W. 9.5' (10.48') --- 15" (16") Black
Ash North 3.6' (4.74') --- 9" Black Ash S.70 W. (S.63 W.) 33.1 (33.39') ---

B. Description of corner evidence found and/or method applied in restoring or reestablishing corner:
Distances to 1986 B.T.s were measured to the B.T. face blaze. Distances
now measured to 10p nail in middle of the side of the tree.

Corner position found marked by the monument as described and the 1986 B.T.s
as noted in parentheses above. Due to recent logging activity, no evidence
remains of the original B.T.s.

Research form on file with Gogebic County records.


Corner recorded in Liber 3, Page 3 on 12/10/86.

C. Description of monument for corner and accessories established to perpetuate locating the position of the corner:

From the above described monument I established the following:

6' Steel sign rail S.23 W. 3.24'

PEER GROUP APPROVED
Richard L. Drahn 5/12/97
COUNTY REPRESENTATIVE

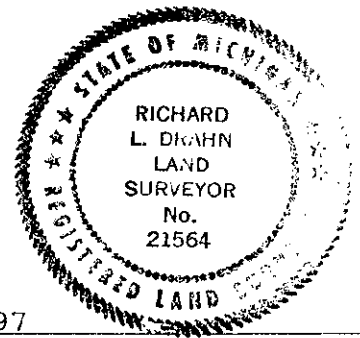

Signed by Richard L. Drahn

Date May 6, 1997

Surveyor's Michigan License No. 21564