

SURVEY & REMONUMENTATION

NOV 12 1997

COMMISSION

LAND CORNER RECORDATION CERTIFICATE
Filing Requirement of Act 74, Mich. P.A. 1970

Register's Office }
Gogebic County } ss.

Received for record the
9th day of OCTOBER
A. D. 1997 at 11:00 o'clock
A m., and recorded in
Liber 6 of CORNERS
on page 236
Ramona Collins, Deputy
Register of Deeds

For corners in

Gogebic (County)	Located in:	Corner Code #
1. Public Land Survey	Section 2 45N 45W	I-4
	T R	
	T R	
	T R	
	T R	
2. Property Controlling in Section	S T R	
	S T R	
3. Miscellaneous Property in Sec.	S T R	
	S T R	


Register of Deeds Stamp & File Number

4. Lot No. _____, Recorded Plat _____
5. Private Claims _____

1/4 corner to section 10 & 11.

I, John R. Garske, in a field survey on Sept. 9, 1997 do hereby state that under requirements of P.A. 74, Michigan P.A. of 1970, the corner points mentioned in lines 1 and 2 above were in conformance with regulations and rules therefore as required in the current manual of survey instructions of the United States Department of the Interior, Bureau of Land Management or by a decree of a Court of Law and/or that the corner points mentioned in lines 3, 4 and 5 above were in conformance with the rules of the Michigan Board of Land Surveyors or by a Decree of a Court of Law; established, re-established, monumented, recovered, found as expressed below:

NOTE: Not more than 2 corners, all in the same town and range, may be recorded on this certificate.

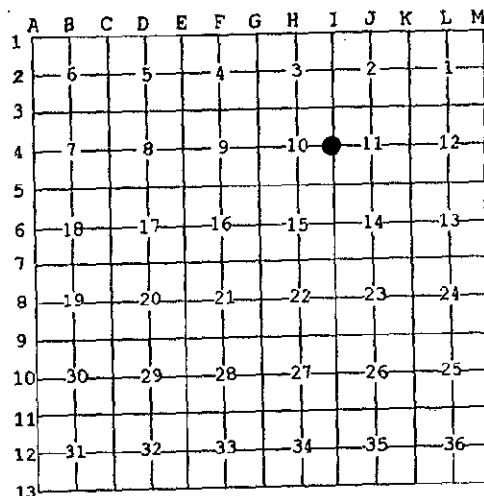

A. Description of original monument and accessories and/or subsequent restoration:

Original survey by Austin Burt, D.S. in 1851
set a wood post from which:
Tamarack 12" - S48W 9 links
Hemlock - 14" N53E 17 links

1956-Anthony Genisot P.E. 7409, shows corner on Plat of Chaney Lake, BT's: Hem. N83°-45'E-16', Cedar N25°-30'W-8.5'

B. Description of corner evidence found and/or method applied in restoring or reestablishing corner:

PEER GROUP APPROVED
Richard P. Deahn 10/10/97
COUNTY REPRESENTATIVE

I found a wooden post at the corner position, squared & scribed. I also found both of Genisot's B.T's, the cedar is alive and standing with scribing visible and the hemlock now a dead 3 foot stub, but scribing still visible. There are ax blazes of different ages on many trees pointing toward the wood post. I monumented this position as the true location of the original corner.

(Research on file)

C. Description of monument for corner and accessories established to perpetuate locating the position of the corner:

I set a 3/4" x 3 foot long alum. rod with a 3 1/4" dia. alum. cap stamped to identify the corner; from which I established;

14" maple	S48°E	41.56 feet
12" cedar	S50°E	24.76 feet
10" cedar	N21°W	8.82 feet (existing)
6' steel sign rail	N60°E	1.51 feet
Dead hemlock stump -	N85°E	16.3 feet (existing)
21± due west to shore of Joann Lake		

Signed by John R. Garske
Surveyor's Michigan License No. 28416

Date 10/10/97

