

**SURVEY &
REMONUMENTATION**

AUG 08 1997

COMMISSION LAND CORNER RECORDATION CERTIFICATE
Filing Requirement of Act 74, Mich. P.A. 1970

Register's Office }
Gogebic County } ss.

For corners in Gogebic Located In: _____ Corner Code # _____
(County)

Received for record the
16th day of JULY
A. D. 1997 at 1:40 o'clock
P m., and recorded in
Lib. 6 of CORNERS
on page 159
Colleen M. Kibak
Deputy Register of Deeds

Register of Deeds Stamp & File Number

1. Public Land Survey	Section 2	T <u>46N</u>	R <u>45W</u>	J- <u>13</u>
		<u>45N</u>	R <u>45W</u>	J- <u>1</u>
		T _____	R _____	_____
		T _____	R _____	_____
2. Property Controlling in Section	S _____	T _____	R _____	_____
	S _____	T _____	R _____	_____
3. Miscellaneous Property In Section	S _____	T _____	R _____	_____
	S _____	T _____	R _____	_____

4. Lot No. _____, Recorded Plat _____
5. Private Claims _____
One-quarter corner common to sections 35 and 2 T46N: T45N, R45W.

John R. Garske June 4 97

I, _____, in a field survey on _____, 19 _____, do hereby certify that under requirements of P.A. 74, Michigan P.A. of 1970, the corner points mentioned in lines 1 and 2 above were in conformance with regulations and rules therefore as required in the current manual of survey instructions of the United States Department of the Interior, Bureau of Land Management or by a decree of a Court of Law and/or that the corner points mentioned in lines 3, 4 and 5 above were in conformance with the rules of the Michigan Board of Professional Surveyors or by a Decree of a Court of Law; established, re-established, monumented, re-monumented, recovered, found as expressed below:

NOTE: Not more than 4 corners, all in the same town and range, may be recorded on this certificate.

A. Description of original monument and accessories and/or subsequent restoration:

In 1847, John Burt D.S., and Austin Burt, D.S., set a cedar post from which a
22" Tamarack N29E 43 lks.
5" Black Ash N35W 5 lks.

B. Description of corner evidence found and/or method applied in restoring or reestablishing corner:

I found a 2"x2" square post, 2640'± from the section corner. I accepted the post as the correct location as established by Keweenaw Land Cruisers in the mid 1950's from an old post they found. I found the old post lying down next to the newer one. This corner location is consistent with the GLO swamp call west of 10 chains (660') and top of ridgell chains (726') and the 13.22 chains east to the stream (872.50ft) I found no remains of the original bearing trees, but since this corner location has been used and accepted for many years I feel it is the best position for the GLO location.


Corner Research on file.

PEER GROUP APPROVED
Richard L. Decker 7/15/97
COUNTY REPRESENTATIVE

C. Description of monument for corner and accessories established to perpetuate locating the position of the corner:

I set a 3 1/4" diameter aluminum cap atop a 3/4" x 48" long aluminum rod. The cap was stamped to read County Remonumentation, T46N, T45N, R45W, 1/4 cor., 35&2, R>L.S. 28410, 6-4-97. The following witness objects were established:

- Balsam 5" N45°W - 23.18'
- Balsam 8" N85°E - 9.78'
- Black spruce 14" S15°E - 13.95'
- 6' Steel sign rail S50°W - 1.71'

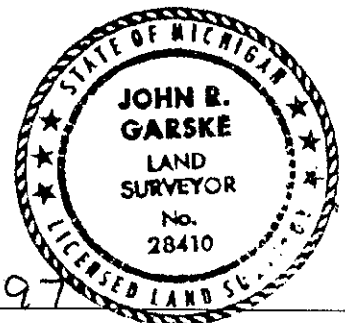

Signed by John R. Garske
Surveyor's Michigan License No. 28410

Date 7/15/97