

# LAND CORNER RECORDATION CERTIFICATE

## FILING REQUIREMENT OF ACT 74, MICH. P.A.1970

GOGEBIC COUNTY

FOR CORNERS OF--:	LOCATED IN--:	CORNER CODE NUMBER
1. PUBLIC LAND SURVEY _____	T. 45 N. 44 W.	A-2
2. PROPERTY CONTROLLING IN SECTION _____	T. 45 N. 45 W.	M-2
3. MISCELLANEOUS PROPERTY IN SECTION _____	T. _____ N. _____ E. _____ S. _____ R. _____ W. _____	
4. LOT NO. _____, RECORDED PLAT _____		
5. PRIVATE CLAIMS _____		

Quarter corner 6 and 1; T.45N., R.44-45W.

Register's Office } ss.  
Gogebic County }

Received for record the  
5<sup>TH</sup> day of JANUARY  
A. D. 1993 at 10:05 o'clock  
A. M., and recorded in  
Liber 4 of CORNERS  
on page 343  
*Betty Anne Deputy*  
Register of Deeds

REGISTER OF DEEDS STAMP AND  
FILING NUMBER

I, Richard L. Drahn do hereby certify that under requirements of P.A. 74, Michigan P.A. of 1970, the corner points mentioned in lines 1 and 2 above (identified with circles on index code diagram - over) were, in a field survey on October 21 1993, established, re-established, monumented, re-monumented, recovered or restored as expressed below and in conformance with regulations and rules therefore as required in the current manual of survey instructions of the United States Department of the Interior, Bureau of Land Management or by a decree of a court of law. Furthermore, that the corner points mentioned in lines 3, 4 and 5 above were, in a field survey on \_\_\_\_\_ 19\_\_\_\_, found, recovered, restored, established or re-established as expressed below and in conformance with the rules of the Michigan State Board of Registration for Land Surveyors or, by a Decree of a Court of law:

A. Description of original monument and accessories and/or subsequent restoration:  
Original corner established by Austin Burt, U.S. Deputy Surveyor on August 28, 1847.  
Original bearing trees:

Y. Birch	24"	N.34°E.	22 links	(14.52 feet)
Cedar	12"	S.61°W.	28 links	(18.48 feet)

No record of subsequent corner restoration found.

B. Description of corner evidence found and/or method applied in restoring or re-establishing corner:

Restored corner at record bearing and distance from the badly decayed remains of the original yellow birch bearing tree. It is now a series of root remains from a 30" yellow birch, the only large remains of a yellow birch recovered in the area. No evidence remains of the cedar bearing tree. Corner location lays within 1.7 feet of a mathematical analysis of this corner location. RRJ

**PEER GROUP APPROVED**  
*Richard L. Drahn 1/20/94*  
**COUNTY REPRESENTATIVE**

C. Description of monument for corner and accessories established to perpetuate locating the position of the corner:

At the corner position I set a 3/4" outside diameter by 4' long aluminum rod monument with a 3" cast aluminum cap, stamped to read: T.45N., R.44-45W.; 1/4; S-6, S-1; 1993; R.L.S. 21564. From which I have established the following new blazed and scribed bearing trees:

10"	Cedar	N.84°E.	35.21 feet
16"	Cedar	S.15°E.	7.96 feet
14"	Hemlock	N.66°W.	55.68 feet
6'	Steel rail	S.56°E.	2.0 feet


SIGNED BY \_\_\_\_\_ DATE \_\_\_\_\_

SURVEYOR'S MICHIGAN REGISTRATION NO. \_\_\_\_\_

FOR STATE AND UNITED STATES AGENCIES:

SIGNED BY \_\_\_\_\_ DATE \_\_\_\_\_

APPROVED AND SIGNED BY Richard L. Drahn CHIEF OF SURVEY PARTY DATE December 22, 1993  
MICHIGAN REGISTERED LAND SURVEYOR

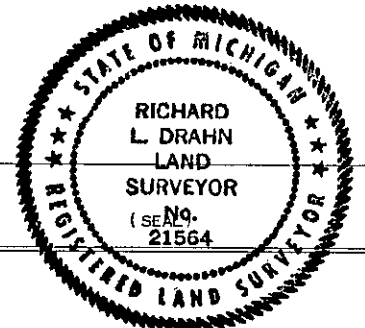

FED C-1

SURVEYOR'S MICHIGAN REGISTRATION NO. 21564