

## MAR 0.2 2000

5. Private Claims

| For corners in SECTIO                | Filing Regui                | ER RECORDATION CERTIFICATE rement of Act 74, Mich. P.A. 1970 | Received for record the 10 day of Junia.  A. B. 19 27 at 10:05 o'clock |
|--------------------------------------|-----------------------------|--|--|
| Gogebic<br>(County)                  | Located In:                 | Corner Code #  |  |
| 1. Public Land Survey                | T45N R46W T R T R T46N R46W | K-13   | A m., and recorded in Liber 2 of CORAINER PRINCIPLE COLUMN Deput       |
| 2. Property Controlling in Section   | S T R<br>S T R              |  | Register of Decida   |
| 3. Miscellaneous<br>Property in Sec. | S T R<br>S T R              |  | Register of Deeds Stamp & File Number                                  |
| A Lot No. Re                         | corded Dist                 |  |  |

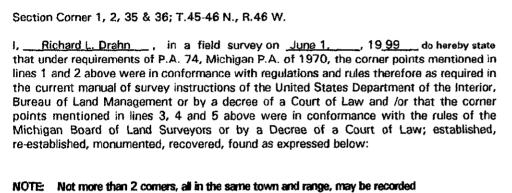

on this certificate.

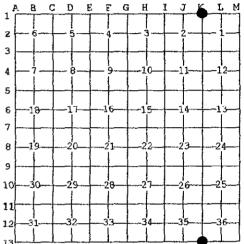

Hannter's Office

Original corner established by John Burt on 8/31/1847. Original bearing trees:

Description of original monument and accessories and/or subsequent restoration:

Hemlock N.11° E. 29 links (19.14')

Cedar 6" N.77° W. 48 links (31.68') S.20° W. 10" 24 links (15.84') Cenar S.81° E. 14' 18 links (11.88') Hemlock

Description of corner evidence found and/or method applied in restoring or reestablishing corner:

21564

Corner position restored at record bearing and distance from the remains of the following original B.T.s:

Stump hole with fragments of Hemlock bark at N.11° E. 19.1' Series of root holes with fragments of Cedar wood at N.77° W. 31.7' Windthrown stump hole with portions of Cedar wood downwind at S.20° W. 15.8' 18-24" decayed Hemlock stump with portions of B.T. blaze overgrowth at S.81° E. 11.9'

Corner research on file with Gogebic County records.

C. Description of monument for corner and accessories established to perpetuate locating the position of the corner:

At the corner position I set a 3/4" X 3' long aluminum rod with a 3 1/4" stamped aluminum cap and the following new B.T.s:

15" N.75° E. 36.75 Cedar S.35° W. 14" 35.66' Cenar N 76° W. 49.75 Hemlock 6" S.23° W. 1.87 Steel sign rail 6



Date <u>June 5, 1999</u> FORM APPROVED BY MICHGAN STATE BOARD OF PROFESSIONAL SURVEYORS, JAN. 28, 1971

Surveyor's Michigan License No. **USFS A-21** 

REVISED MAY 14,1975 REVISED JAN., 1983 REVISED OCT., 1995