

SURVEY & REMONUMENTATION

SEP 08 1998

SECTION

LAND CORNER RECORDATION CERTIFICATE
Filing Requirement of Act 74, Mich. P.A. 1970

Register's Office }
Gogebic County } ss.

For corners in
Gogebic

Received for record the

14TH day of MAY

A. D. 1998 at 3:00 o'clock

P m., and recorded in

Liber 6 of CORNERS

page 332

Ramon Collins, Deputy
Register of Deeds

Register of Deeds Stamp & File Number

Located In: Corner Code #

Section 7	46N	42W	C-5	
	T	R		
	T	R		
	T	R		
	T	R		
2. Property Controlling in Section	S	T	R	
	S	T	R	
3. Miscellaneous Property in Sec.	S	T	R	
	S	T	R	

1. Public Land Survey

2. Property Controlling in Section

3. Miscellaneous Property in Sec.


4. Lot No. _____, Recorded Plat _____

5. Private Claims _____

Section corner to 7, 8, 17 and 18, T46N, R42W

I, John R. Garske, in a field survey on February 25, 1998 do hereby state that under requirements of P.A. 74, Michigan P.A. of 1970, the corner points mentioned in lines 1 and 2 above were in conformance with regulations and rules therefore as required in the current manual of survey instructions of the United States Department of the Interior, Bureau of Land Management or by a decree of a Court of Law and /or that the corner points mentioned in lines 3, 4 and 5 above were in conformance with the rules of the Michigan Board of Land Surveyors or by a Decree of a Court of Law; established, re-established, monumented, recovered, found as expressed below.

NOTE: Not more than 2 corners, all in the same town and range, may be recorded on this certificate.

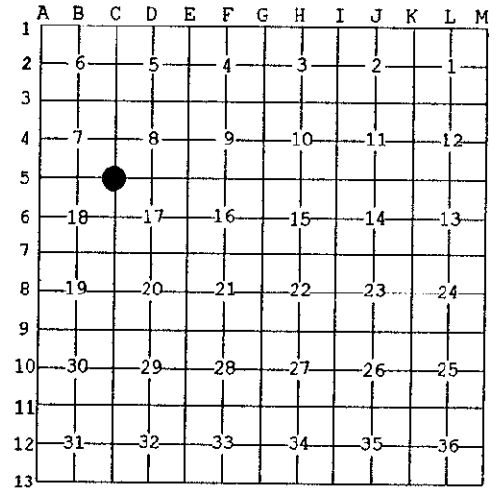

A. Description of original monument and accessories and/or subsequent restoration:

- Original Township survey by Algermon Merryweather, D.S. in 1851.
Original Bearing Trees:

sugar Maple 12" S30°E 38 links
Hemlock 18" N65°W (no distance)

- Corner restored by Donald Lappala, RLS in 1968. He found remains both of the original bearing trees. He set a 2" x 5' galv. iron pipe with a 3" dia. brass cap, with bearing trees noted below. Corner recorded 8/29/69 in L1, pg. 85.

B. Description of corner evidence found and/or method applied in restoring or reestablishing corner:

I found Lappala's monument as noted above in good condition. His bearing trees are as follows:


(8") 12" yellow birch	N82°W	23.46 feet (23.4')
(11") 5" hemlock	S39°W (S34°W)	24.65 feet (24.6')
(11") 14" hemlock	N46°E (42°E)	43.10' (43.0')
(3) 18" sugar	N44°W	26.08 feet (set in 1985 by U.S.F.S.)

(Research on file)

FEEL GROUP APPROVED
Richard P. Dean 5/13/98
COURT RECORDING

C. Description of monument for corner and accessories established to perpetuate locating the position of the corner:

I found Lappala's monument from which I established:
10" y. birch S80°W 41.13 feet
Steel sign rail South 2.55 feet (existing)

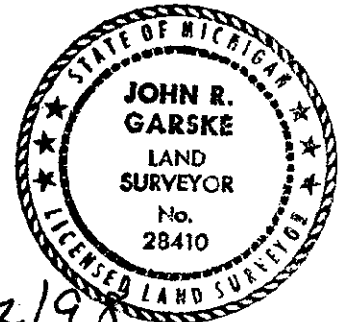

Signed by John R. Garske
Surveyor's Michigan License No. 28410

Date 5/12/98