

LAND CORNER RECORDATION CERTIFICATE
Filing Requirement of Act 74, Mich. P.A. 1970

Register's Office }
 Gogebic County } ss.

For corners in
Gogebic
 (County)

Located In: _____ Corner Code # _____

Received for record the
26th day of JANUARY
 A. D. 1995 at 10:56 o'clock
17 m., and recorded in
 Liber 5 of CORNERS
 on page 183.
Barbara Collins Deputy
 Register of Deeds

1. Public Land Survey Section 35 T 47N R 42W K-13
 T _____ R _____
 T 46N R 42W K-1
 T _____ R _____
 T _____ R _____
2. Property Controlling S _____ T _____ R _____
 in Section S _____ T _____ R _____
3. Miscellaneous S _____ T _____ R _____
 Property in Sec. S _____ T _____ R _____

Register of Deeds Stamp & File Number

4. Lot No. _____, Recorded Plat _____
5. Private Claims _____
 Section corner to 35, 36 and 1, 2, T47-46N, R42W

A	B	C	D	E	F	G	H	I	J	K	L	M
2	6	5	4	3	2	1						
3												
4	7	8	9	10	11	12						
5												
6	18	17	16	15	14	13						
7												
8	19	20	21	22	23	24						
9												
10	30	29	28	27	26	25						
11												
12	31	32	33	34	35	36						
13												

I, John R. Garske, In a field survey on October 14, 1994, do hereby certify that under requirements of P.A. 74, Michigan P.A. of 1970, the corner points mentioned in lines 1 and 2 above were in conformance with regulations and rules therefore as required in the current manual of survey instructions of the United States Department of the Interior, Bureau of Land Management or by a decree of a Court of Law and/or that the corner points mentioned in lines 3, 4 and 5 above were in conformance with the rules of the Michigan Board of Land Surveyors or by a Decree of a Court of Law; established, re-established, monumented, re-monumented, recovered, found as expressed below:

NOTE: Not more than 4 corners, all in the same town and range, may be recorded on this certificate.

A. Description of original monument and accessories and/or subsequent restoration:

Original survey by William A. Burt, Deputy Surveyor, in 1847. Set a hemlock post from which a:
 12" Sugar - N54°E - 17 links 18" sugar maple - S28°W - 13 links
 19" sugar - N57°W - 36 links 10" elm - S50°E - 33 links

1961 - Kimberly Clark Surveyor, Neil Sperhake, RLS 7876, set a 4" diameter aluminum cap on a 1 1/4" diameter pipe at the corner position (see reference below).

1969 - Corner recorded by Don Lappala, RLS 12585, April 17, 1969, in USFS Liber pg. A-21, LI, pg 85 of Register of Deeds (see reference below).

B. Description of corner evidence found and/or method applied in restoring or reestablishing corner:

I found the Sperhake (Kimberly-Clark Corporation) monument in good condition with his bearing trees, a 14" sugar maple - N26°W - 56.1 feet; 11" hemlock - N52°E - 44.2 feet; 6" elm - S08°E - 40.9 feet; 10" hemlock - S56°W - 44.9 feet (all destroyed). Lappala's bearing trees: 5" yellow birch at N26°E - 21.0 feet is in good condition but the 3" elm at S75°W - 16.0 feet is destroyed. I updated the corner to county specs as noted below.

County record research on file with Register of Deeds.

PEER GROUP

Approved


Richard P. Deahn

1/25/95

C. Description of monument for corner and accessories established to perpetuate locating the position of the corner:

Found a 4" diameter stamped aluminum cap on a 1 1/4" diameter pipe from which I established the following bearing trees and reference objects:

- 5" ash - S22°E - 8.12 feet
- 4" maple - N81°E - 13.20 feet
- 9" Y. birch - N30°E - 21.13 feet (existing)
- Steel sign post - Due West - 1.50 feet

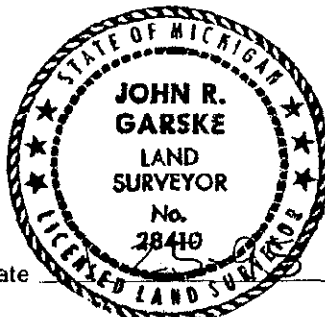

Signed by John R. Garske
 Surveyor's Michigan License No. 28410

Date _____