

SURVEY &
REMONUMENTATION

JAN 20 1999


SECTION

LAND CORNER MONUMENTS

T. 46 N., R. 42 W.

MARENISCO TOWNSHIP

Comp 3/3/95 - #13
Comp 5/10/95 - 14

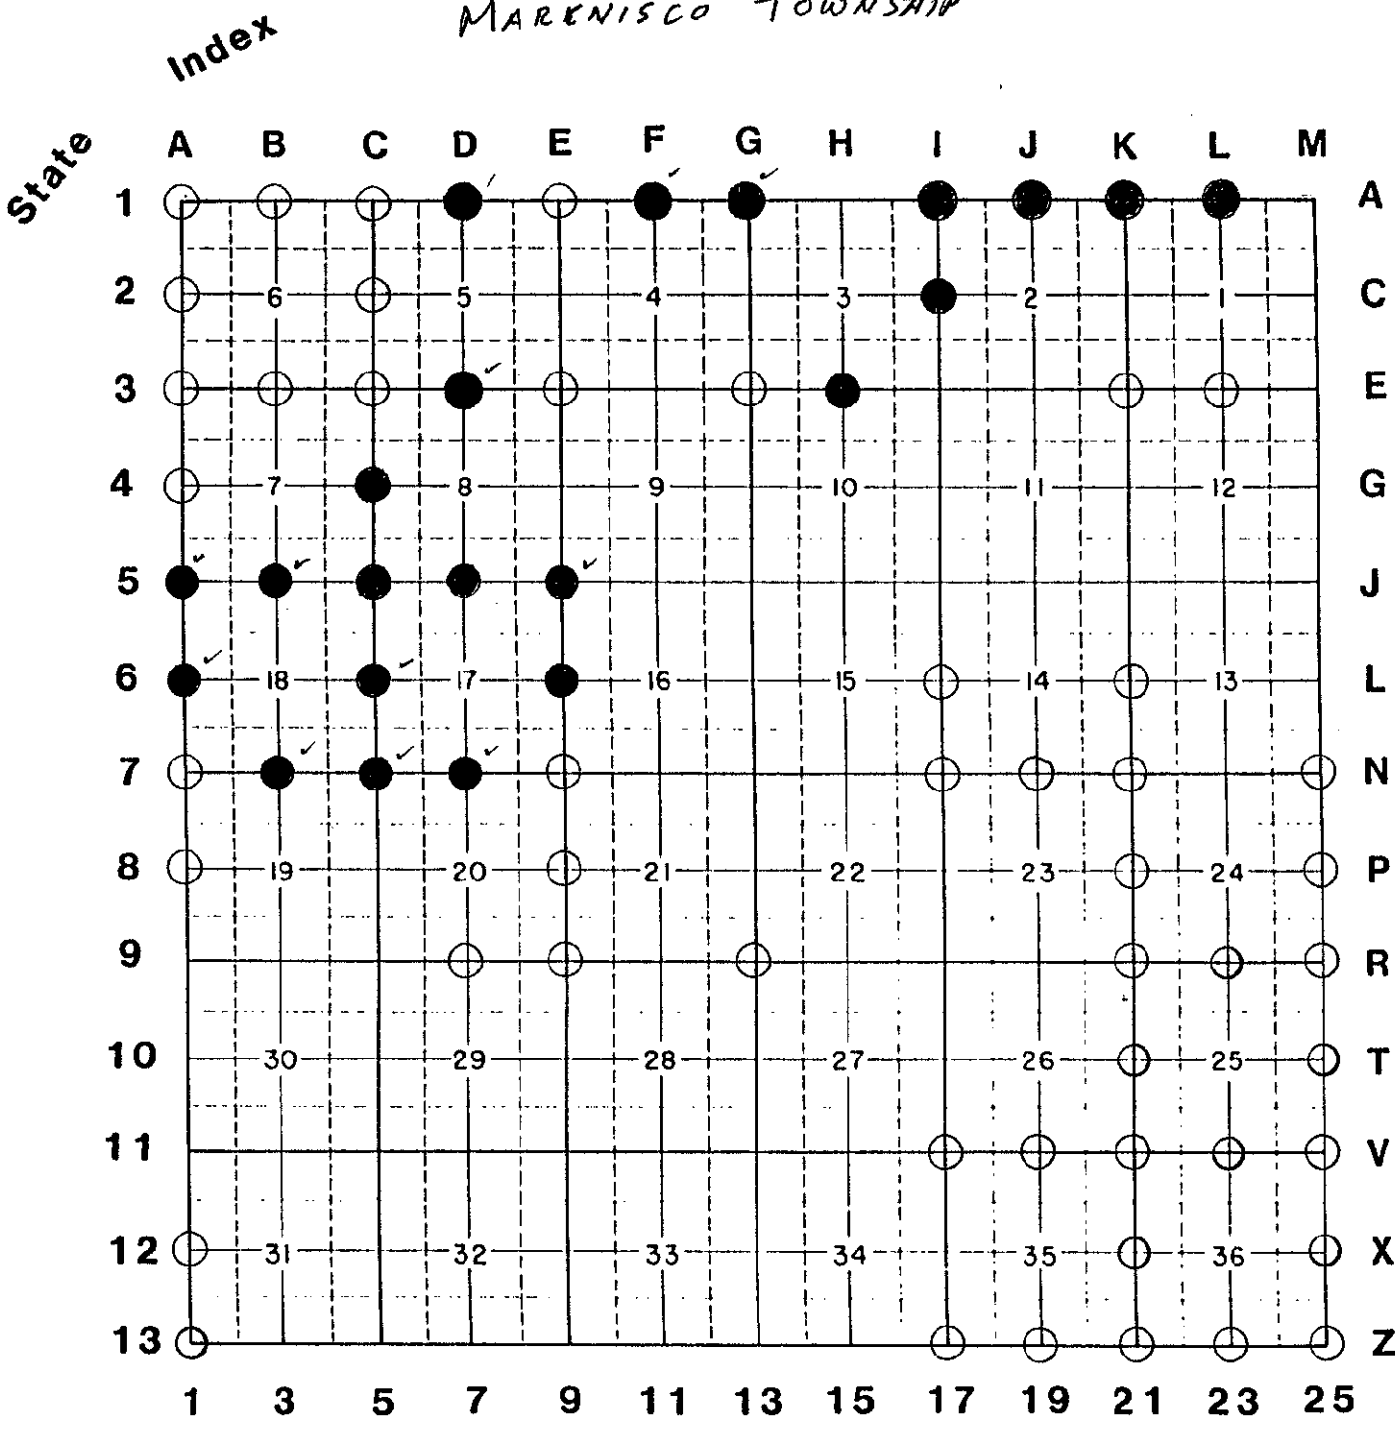

AS OF 12/31/98

LEGEND

- GLO Corners researched
- ⊙ GLO Corners monumented, not approved
- ⊗ GLO Corners approved
- GLO Corners approved & reported to State

T. 46 N., R. 42 W.