

DEC 15 1998

SECTION

LAND CORNER RECORDATION CERTIFICATE
Filing Requirement of Act 74, Mich. P.A. 1970

Register's Office }
Gogebic County } ss.

For corners in

Gogebic

(County)

Located In:

Corner Code #

1. Public Land Survey

<u>T.46N R.43W</u>	<u>A-1</u>
T.46N R.44W	M-1
T.47N R.43W	A-13
T.47N R.44W	M-13

2. Property Controlling in Section

S	T	R	
S	T	R	
S	T	R	
S	T	R	

3. Miscellaneous Property in Sec.

4. Lot No. _____, Recorded Plat _____
5. Private Claims _____

Section corner common to sec's. 1,6,31 & 36
T.46N, R.43-44W; T.47N, R.43-44W &

I, John P. Goss, in a field survey on Sept. 119 98 do hereby state that under requirements of P.A. 74, Michigan P.A. of 1970, the corner points mentioned in lines 1 and 2 above were in conformance with regulations and rules therefore as required in the current manual of survey instructions of the United States Department of the Interior, Bureau of Land Management or by a decree of a Court of Law and/or that the corner points mentioned in lines 3, 4 and 5 above were in conformance with the rules of the Michigan Board of Land Surveyors or by a Decree of a Court of Law; established, re-established, monumented, recovered, found as expressed below:

NOTE: Not more than 2 corners, all in the same town and range, may be recorded on this certificate.

Received for record the
17th day of SEPTEMBER
A. D. 1998 at 1:15 o'clock
P m., and recorded in
Liber 7 of CORNERS
on page 54
Remona Collins Deputy
Register of Deeds

Register of Deeds Stamp & File Number

	A	B	C	D	E	F	G	H	I	J	K	L	M
1													
2	6		5		4		3		2		1		
3													
4	7		8		9		10		11		12		
5													
6	18		17		16		15		14		13		
7													
8	19		20		21		22		23		24		
9													
10	30		29		28		27		26		25		
11													
12	31		32		33		34		35		36		

A. Description of original monument and accessories and/or subsequent restoration:

Corner established by Austin Burt, U.S. Deputy Surveyor, in 1847.
Original bearing trees: Black Ash 10" S 48° W 18 links
Herlock 12" S 77° E 12 links

On June 4, 1971, Donald D. Lappala, R.L.S., USFS, restored corner position at record bearing and distance from remains of two original bearing trees. He set a 2½" I.D. iron pipe, capped with a 3" Bronze tablet which reads: T.46-47 N, R.43-44 W; S-, S-6, S31, S-36; R.L.S. 12585; 1971, from which he established the following reference objects: 7" Red Maple - N 37° E - 13.1'; 6" Spruce - S 60° E - 33.4'; 6" Red Maple - S 11° E - 28.1'; 4"x4" Cedar sign post - S 58° E - 2.4'

B. Description of corner evidence found and/or method applied in restoring or reestablishing corner:
He record said corner in U.S. Forest Service Liber Z-25 on August 10, 1972.

Found D. Lappala monument and reference objects.

I updated the monument and accessories as noted below to state and county specification.

Act 74 research on file.

PEER GROUP APPROVED


Richard P. Deahn 9/16/98
COUNTY REGISTER

C. Description of monument for corner and accessories established to perpetuate locating the position of the corner:

From found monument I established the following existing and new reference objects:

9" Red Maple	N 37° E	13.11'
9" Spruce	S 60° E	33.61'
11" Red Maple	S 11° E	28.07'
4"x4" Cedar sign post	S 58° E	2.34' to face
6' Rail & Sign	N 10° W	1.92' to face

(All measurement taken to nail in side of tree)

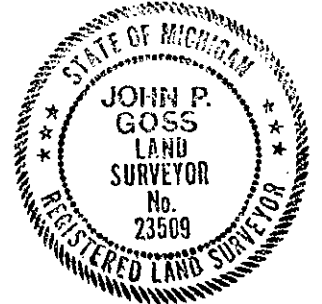

Signed by John P. Goss

Date Sept. 1, 1998

Surveyor's Michigan License No. 23509

U.S.F.S. No. Z-25