

SURVEY & REMONUMENTATION

SEP 08 1998

LAND CORNER RECORDATION CERTIFICATE
Filing Requirement of Act 74, Mich. P.A. 1970

SECTION
 For corners in

Gogebic
 (County)

Located In:

Corner Code #

- | | | |
|------------------------------------|---------------------------|-------|
| 1. Public Land Survey | T <u>46N</u> R <u>44W</u> | M-3 |
| | T _____ R _____ | _____ |
| | T _____ R _____ | _____ |
| | T <u>46N</u> R <u>43W</u> | A-3 |
| 2. Property Controlling in Section | S _____ T _____ R _____ | _____ |
| 3. Miscellaneous Property in Sec. | S _____ T _____ R _____ | _____ |

4. Lot No. _____, Recorded Plat _____
 5. Private Claims _____

Section Corner 1, 12, 6 & 7; T.46 N., R.43-44 W.

Richard L. Drahn in a field survey on April 9, 1998, do hereby certify that under requirements of P.A. 74, Michigan P.A. of 1970, the corner points mentioned in lines 1 and 2 above were in conformance with regulations and rules therefore as required in the current manual of survey instructions of the United States Department of the Interior, Bureau of Land Management or by a decree of a Court of Law and/or that the corner points mentioned in lines 3, 4 and 5 above were in conformance with the rules of the Michigan Board of Land Surveyors or by a Decree of a Court of Law; established, re-established, monumented, re-monumented, recovered, found as expressed below:

NOTE: Not more than 4 corners, all in the same town and range, may be recorded on this certificate.

A. Description of original monument and accessories and/or subsequent restoration:

Corner established by Austin Burt on 8/9/1847. Original B.T.s: --- Y. Birch 12" S.52 W. 31 links (20.46') --- Cedar 14" N.44 E. 26 links (17.16') --- Hemlock 14" S.85 E. 36 links (23.76') --- Y. Birch 12" N.19 W. 26 links (17.16')
 Corner position restored by Richard L. Drahn (21564) on 5/26/82 from the decayed remains of the four original B.T.s. He set a 2" X 30" aluminum pipe with a 3 1/4" stamped aluminum cap and the following new bearing trees:

- | | | | |
|-----|-----------------|---------|--------|
| 6" | Hemlock | N.74 W. | 11.62' |
| 12" | Hemlock (twin) | N.65 E. | 38.82' |
| 8" | Yellow Birch | S.71 E. | 27.85' |
| 6' | Steel sign rail | N.73 W. | 1.8' |

B. Description of corner evidence found and/or method applied in restoring or reestablishing corner:

Corner recorded in Gogebic County, Liber 2, Page 408, on 3/15/83.

Corner research on file with Gogebic County records.

Recovered the monument as described and the bearing trees as follows:

- | | | | |
|-----|-----------------|---------|--------|
| 8" | Hemlock | N.76 W. | 11.63' |
| 13" | Twin Hemlock | N.65 E. | 38.82' |
| 10" | Yellow Birch | S.72 E. | 27.82' |
| 6' | Steel sign rail | N.73 W. | 1.83' |

No evidence remains of the original corner post. A stump hole remains from the the first original B.T.; A 18" downed Cedar with remnants of the original blaze from the second, and decayed Birch and Hemlock stumps remain from the last two.

C. Description of monument for corner and accessories established to perpetuate locating the position of the corner:

New bearing tree referenced:

- | | | | |
|----|-------------|---------|--------|
| 5" | Sugar Maple | N.19 W. | 31.27' |
|----|-------------|---------|--------|


PEER GROUP APPROVED
Richard L. Drahn 5/13/98
 COUNTY SURVEYOR



Signed by Richard L. Drahn

Date April 12, 1998

Surveyor's Michigan License No. 21564

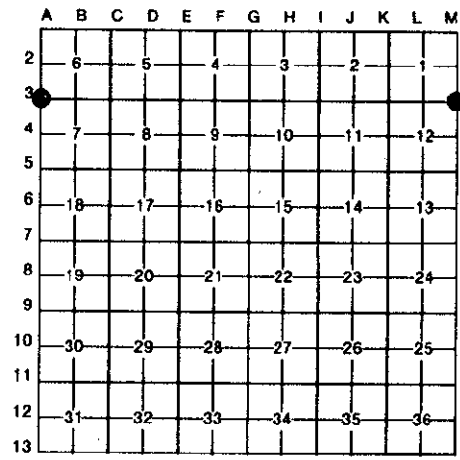

Register's Office }
 Gogebic County } ss.
 Received for record the
14th day of MAY
 A. D. 1998 at 3:10 o'clock
P m., and recorded in
 Liber 6 of CORNERS
 on page 352
Ramona Collins, Deputy
 Register of Deeds
 Register of Deeds Stamp & File Number