SURVEY & REMONUMENTATION

SEP 0 8 1998

SECTION

Register's Office
Gogebic County } ss.

Received for record the 14TH day of MAY A. D. 1998 at 3:10 o'clock P m., and recorded in Liber 6 of CORNERS on page 354

Ramona Collins, Deputy
Register of Deeds

Register of Deeds Stamp & File Number

LAND CORNER RECORDATION CERTIFICATE

Filing Requirement of Act 74, Mich. P.A. 1970

For corners in Gogebic (County)

	Located In:	Corner Code #
1. Public Land Survey	T46N R 44W	M-5
	T R	
	T R	
	T46N R 43W	A-5
2. Property Controlling	S T R	
in Section	S T R	
3. Miscellaneous	S T R	
Property in Sec.	S T R	

4. Lot No. _____ , Recorded Plat _____
5. Private Claims _____

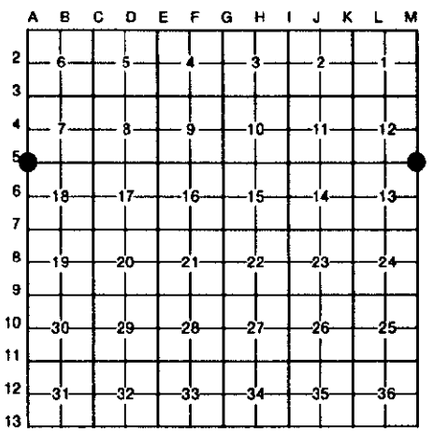

Section Corner 12, 13, 7 & 18; T.46 N., R.43-44 W.

I, Richard L. Drahn in a field survey on April 9, , 19 98 , do hereby certify that under requirements of P.A. 74, Michigan P.A. of 1970, the corner points mentioned in lines 1 and 2 above were in conformance with regulations and rules therefore as required in the current manual of survey instructions of the United States Department of the Interior, Bureau of Land Management or by a decree of a Court of Law and/or that the corner points mentioned in lines 3, 4 and 5 above were in conformance with the rules of the Michigan Board of Land Surveyors or by a Decree of a Court of Law; established, re-established, monumented, re-monumented, recovered, found as expressed below:

NOTE: Not more than 4 corners, all in the same town and range, may be recorded on this certificate.

A. Description of original monument and accessories and/or subsequent restoration:

Corner established by Austin Burt on 8/9/1847. Original B.T.s --- Y. Birch 34" S.85 W. 20 links (13.20') --- Spruce 14" N.62 E. 37 links (24.42') --- Spruce 6" S.41 E. 42 links (27.72') --- Sugar 12" N.33 W. 28 links (18.48') Corner position re-established by Richard L. Drahn (21564) on 10/22/82 by single proportionate methods. He set a 2" X 30" aluminum pipe with a 3¼" stamped aluminum cap and the following new bearing trees:

10"	Red Maple	N.31 W.	37.67'
13"	Sugar Maple	S.81 E.	45.73'
8"	Sugar Maple	S.15 E.	15.03'
6'	Steel sign rail	N.01 W	3.1'

B. Description of corner evidence found and/or method applied in restoring or reestablishing corner:

Corner recorded in Gogebic County Liber 2, Page 412 on 3/15/83.

Corner research on file with Gogebic County records.

Recovered the monument as described and the bearing trees as follows:

12"	Red Maple	N.31 W.	37.59 (new nail)
14"	Sugar Maple	S.83 E.	45.81'
11"	Sugar Maple	S.15 E.	14.76' (new nail)
6'	Steel sign rail	N.03 W.	3.02'

No evidence of the original corner or B.T.s remains.

C. Description of monument for corner and accessories established to perpetuate locating the position of the corner:

New bearing tree referenced:

10"	Twin Sugar Maple	N.34 E.	51.91'

PEER GROUP APPROVED
Richard L. Drahn 5/13/98
COUNTY REPRESENTATIVE

STATE OF MICHIGAN
RICHARD L. DRAHN
LAND SURVEYOR
No. 21564
REGISTERED LAND SURVEYOR

Signed by Richard L. Drahn Date April 12, 1998

Surveyor's Michigan License No. 21564

FORM APPROVED BY MICHIGAN STATE BOARD OF LAND SURVEYORS, JAN. 28, 1971
REVISED MAY 14, 1975
REVISED JAN., 1983

USFS J-25 354