

SURVEY & REMONUMENTATION

NOV 12 1997

COMMISSION

LAND CORNER RECORDATION CERTIFICATE
Filing Requirement of Act 74, Mich. P.A. 1970

For corners in

<u>Gogebic</u> (County)	Located In:	Corner Code #
1. Public Land Survey	T46NR43W	B-7
	T___R___	_____
	T___R___	_____
	T___R___	_____
2. Property Controlling in Section	S___T___R___	_____
	S___T___R___	_____
3. Miscellaneous Property in Sec.	S___T___R___	_____
	S___T___R___	_____
4. Lot No. _____, Recorded Plat _____		
5. Private Claims _____		

Register's Office }
Gogebic County } 88.

Received for record the
9TH day of OCTOBER
A. D. 1997 at 10:50 o'clock
A m., and recorded in
Liber 6 of CORNER
on page 219
Annina Collins, Deputy
Register of Deeds

Register of Deeds Stamp & File Number

A	B	C	D	E	F	G	H	I	J	K	L	M
1												
2	6	5	4	3	2	1						
3												
4	7	8	9	10	11	12						
5												
6	18	17	16	15	14	13						
7	●											
8	19	20	21	22	23	24						
9												
10	30	29	28	27	26	25						
11												
12	31	32	33	34	35	36						
13												

I, John P. Goss, in a field survey on Oct. 2, 1997 do hereby state that under requirements of P.A. 74, Michigan P.A. of 1970, the corner points mentioned in lines 1 and 2 above were in conformance with regulations and rules therefore as required in the current manual of survey instructions of the United States Department of the Interior, Bureau of Land Management or by a decree of a Court of Law and /or that the corner points mentioned in lines 3, 4 and 5 above were in conformance with the rules of the Michigan Board of Land Surveyors or by a Decree of a Court of Law; established, re-established, monumented, recovered, found as expressed below:

NOTE: Not more than 2 corners, all in the same town and range, may be recorded on this certificate.

1/4 cor. comm. to sec's. 18 & 19

A. Description of original monument and accessories and/or subsequent restoration:

Original corner established by Austin Burt on July 17, 1851.
Original bearing trees: Sugar 7" S 48° W 23 links 15.18'
Sugar 14" N 62° E 33 links 21.78'

Corner position re established by Richard Drahn, RLS, on April 29, 1986 on line between and proportionate distance from SE and SW Section corner of Sec. 18, T46N, R43W. He set a 2" iron pipe 18" long with 3" bronze cap stamped to indicate corner position. He established the following reference objects:
11" S. Maple - N 57° W - 16.82'; 10" S. Maple - S 71° E - 35.94'; 9" S. Maple - S 11° W - 56.33'; 6' steel sign post - West - 18.15'; 2 1/2" iron pipe with 3"

B. Description of corner evidence found and/or method applied in restoring or reestablishing corner:

bronze cap reference monument stamped to indicate the corner position - bearing West - 16.57'.

He recorded said corner in Liber 2, page 776 of Land Corners for Gogebic County, Found Richard Drahn corner monument and witnesses.

I updated the corner monument and accessories as noted below to state and county specification.

Act 74 research on file.

C. Description of monument for corner and accessories established to perpetuate locating the position of the corner:

From the 2" iron pipe with 3" bronze cap which read: T.46 N, R.43 W.; 1/4; S-18, S-19; 1986; R.L.S. 21564. That is buried 1', I established the existing and new bearing trees and reference object.

- 14" Sugar Maple N 57° W 16.82'
- 13" Sugar Maple S 71° E 35.94'
- 11" Sugar Maple S 11° W 56.33'
- 9" Sugar Maple N 03° E 54.80'
- 6' Steel sign post West 18.15'


2 1/2" iron pipe with 3" bronze cap stamped to indicate corner position.

West - 16.57' (all measurement at to nail in side of tree)

Signed by John P. Goss
Surveyor's Michigan License No. 23509

Date October 2, 1997

PEER GROUP APPROVED
Richard H. Drahn 10/8/97
COUNTY REPRESENTATIVE

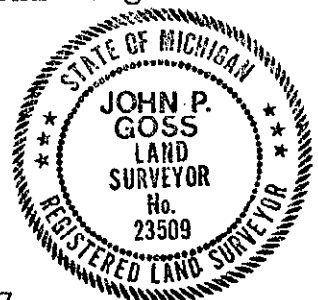

Fed. No. N-3