

**SURVEY &
REMONUMENTATION**

SEP 08 1998

SECTION

LAND CORNER RECORDATION CERTIFICATE
Filing Requirement of Act 74, Mich. P.A. 1970

For corners in		
<u>Gogebic</u>	Located In:	Corner Code #
(County)		
1. Public Land Survey	<u>T46N R 43W</u>	<u>G-3</u>
	T <u> </u> R <u> </u>	<u> </u>
	T <u> </u> R <u> </u>	<u> </u>
	T <u> </u> R <u> </u>	<u> </u>
2. Property Controlling in Section	S <u> </u> T <u> </u> R <u> </u>	<u> </u>
	S <u> </u> T <u> </u> R <u> </u>	<u> </u>
3. Miscellaneous Property in Sec.	S <u> </u> T <u> </u> R <u> </u>	<u> </u>
	S <u> </u> T <u> </u> R <u> </u>	<u> </u>

Register's Office }
Gogebic County } ss.

Received for record the
18TH day of JUNE
A. D. 1998 at 1:15 o'clock
P m., and recorded in
Liber 6 of CORNERS
page 401
Ramona L. Collins, Dep
Register of Deeds
Register of Deeds Stamp & File Number

4. Lot No. _____, Recorded Plat _____
5. Private Claims _____

Section Corner, Sections 5, 6, 7 & 8, T46N, R43W

I, John P. GOSS, in a field survey on May 26, 1998 do hereby state that under requirements of P.A. 74, Michigan P.A. of 1970, the corner points mentioned in lines 1 and 2 above were in conformance with regulations and rules therefore as required in the current manual of survey instructions of the United States Department of the Interior, Bureau of Land Management or by a decree of a Court of Law and /or that the corner points mentioned in lines 3, 4 and 5 above were in conformance with the rules of the Michigan Board of Land Surveyors or by a Decree of a Court of Law; established, re-established, monumented, recovered, found as expressed below:

A	B	C	D	E	F	G	H	I	J	K	L	M
1												
2	6	5	4	3	2	1						
3		●										
4	7	8	9	10	11	12						
5												
6	18	17	16	15	14	13						
7												
8	19	20	21	22	23	24						
9												
10	30	29	28	27	26	25						
11												
12	31	32	33	34	35	36						
13												

NOTE: Not more than 2 corners, all in the same town and range, may be recorded on this certificate.

A. Description of original monument and accessories and/or subsequent restoration:

Corner established by Austin Burt, on August 26, 1851.
Original bearing trees: Sugar 14" S 35° W 15 links (9.90')
Sugar 8" N 82° E 21 links (13.86')

Richard L. Drahn, RLS, USFS, on June 13, 1984, restored corner position at record bearing and distance from the stump holes of the two original bearing trees. Corner position verified by retacement measurement and natural feature ties. He set a 3/4" aluminum rod with a 3/4" aluminum cap, stamped to indicated corner position. He established the following reference objects:
9" Sugar Maple - N 27° W - 34.66'; 6" Sugar Maple - S 82° E - 22.98'

B. Description of corner evidence found and/or method applied in restoring or reestablishing corner:

9" Sugar Maple - S 05° W - 14.36'; 6' steel sign post - N 51° E - 2.2'
He recorded said corner in Liber 2, page 597 of Land Corners for Gogebic County.
No original evidence found.

Found Richard L. Drahn, monument and witnesses.

I updated the monument and accessories as noted below to state and county specification.

Act 74 research on file.

PEER GROUP APPROVED

Richard L. Drahn 6/17/98
COUNTY REPRESENTATIVE

C. Description of monument for corner and accessories established to perpetuate locating the position of the corner:


From the found 3/4" dia. by 4' long solid aluminum rod monument with a 3/2" aluminum cap, with magnet, stamped to read: T.46 N., R.43 W.; S-, S-6, S-7, S-8; 1984; R.L.S. 21564: from which I established existing and new reference objects:

11" Sugar Maple	N 27° W	34.66'
9" Sugar Maple	S 82° E	22.98 new nail
11" Sugar Maple	S 05° W	14.34 new nail
6" Sugar Maple	N 14° E	24.42'
6' steel sign post	N 51° E	2.2' to face

(All measurement taken to nail in side of tree)

Signed by John P. Goss
Surveyor's Michigan License No. 23509

Date May 26, 1998

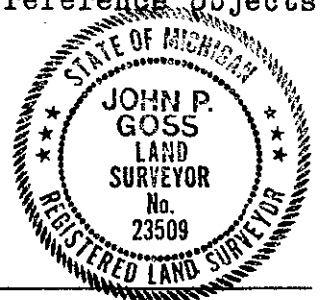

USFS No. E-5