

SURVEY & REMONUMENTATION

SEP 08 1998

SECTION

LAND CORNER RECORDATION CERTIFICATE
Filing Requirement of Act 74, Mich. P.A. 1970

For corners in
Gogebic
(County)

Located In: T46NR 43W Corner Code # C-5

1. Public Land Survey
T R
T R
T R

2. Property Controlling in Section
S T R
S T R

3. Miscellaneous Property in Sec.
S T R

Register's Office }
Gogebic County } ss.

Received for record the
14th day of MAY
A. D. 1998 at 3:00 o'clock
P m., and recorded in
Liber 6 of CORNERS
on page 334.
Ramona Collins Deputy
Register of Deeds


Register of Deeds Stamp & File Number

4. Lot No. _____, Recorded Plat _____
5. Private Claims _____

Section Corner, Section 7, 8, 17 & 18, T46N, R43W

I, John P. Goss, in a field survey on May 4, 1998 do hereby state that under requirements of P.A. 74, Michigan P.A. of 1970, the corner points mentioned in lines 1 and 2 above were in conformance with regulations and rules therefore as required in the current manual of survey instructions of the United States Department of the Interior, Bureau of Land Management or by a decree of a Court of Law and for that the corner points mentioned in lines 3, 4 and 5 above were in conformance with the rules of the Michigan Board of Land Surveyors or by a Decree of a Court of Law, established, re-established, monumented, recovered, found as expressed below:

NOTE: Not more than 2 corners, all in the same town and range, may be recorded on this certificate.

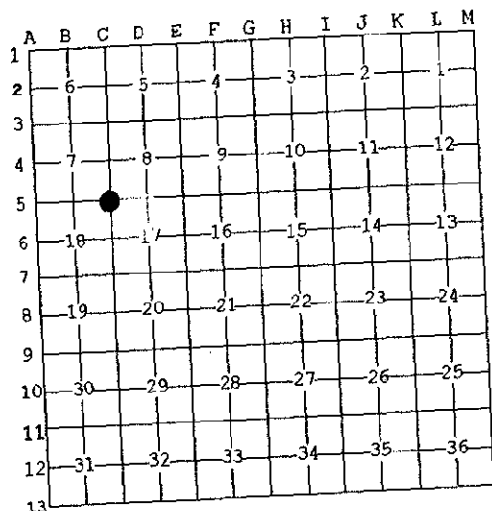


A. Description of original monument and accessories and/or subsequent restoration:
Corner established by Austin Burt, on August 26, 1851.
Original bearing trees: Cedar 14" S 47° W 17 links (11.22')
Y. Birch 14" N 52° E 17 links (11.22')

Richard L. Drahn, RLS, restored this corner position at record bearing and distance from remains of the two original bearing trees, on May 22, 1984. He set a 2" I.D. iron pipe with 3" brass cap, stamped to indicated the corner position. He established the following reference objects:
6" Sugar Maple - N 41° W - 25.28' 11" Yellow Birch - N 76° E - 15.67'
10" Sugar Maple - S 61° W - 40.39' 6' steel sign post - N 06° W - 2.3'

B. Description of corner evidence found and/or method applied in restoring or reestablishing corner:
He record said corner in Liber 2, page 601 of Land Corners for Gogebic County.
Found Richard L. Drahn, monument and witnesses.
I updated the monument and accessories as noted below to state and county specification.
Act 74 research on file.

PEER GROUP APPROVED
Richard L. Drahn 5/13/98
COUNTY REGISTER

C. Description of monument for corner and accessories established to perpetuate locating the position of the corner:
From the 2" I.D. iron pipe with 3" brass cap which reads: T.46 N., R.43 W.; S-8, S-17, S-7, & S-18; 1984; R.L.S. 21564: from which I established the following existing and new reference objects:
8" Sugar Maple N 41° W 25.28 feet
16" Yellow Birch N 76° E 15.67 feet
13" Sugar Maple S 61° W 40.39 feet
6' steel sign post N 06° W 2.3 feet (to face)
10" Sugar Maple S 47° E 15.25 feet

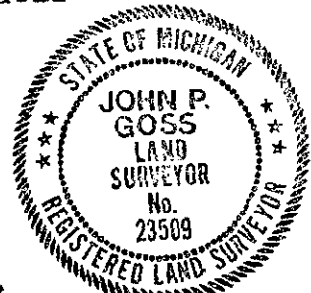

Signed by John P. Goss
Surveyor's Michigan License No. 23509
Fed. No. J-5

Date May 4, 1998