

MAR 02 2000

LAND CORNER RECORDATION CERTIFICATE
Filing Requirement of Act 74, Mich. P.A. 1970

SECTION

For corners in

<u>Gogebic</u> (County)	Located In:	Corner Code #
1. Public Land Survey	T <u>46N</u> R <u>43W</u>	<u>C-11</u>
	T _____ R _____	_____
	T _____ R _____	_____
	T _____ R _____	_____
2. Property Controlling in Section	S _____ T _____ R _____	_____
	S _____ T _____ R _____	_____
3. Miscellaneous Property in Sec.	S _____ T _____ R _____	_____
	S _____ T _____ R _____	_____
4. Lot No. _____, Recorded Plat _____		
5. Private Claims _____		

Register's Office }
Gogebic County } ss.

Received for record the
12TH day of MAY
A. D. 1999 at 11:00 o'clock
A m., and recorded in
Liber 7 of CORNERS
on page 100
Ramona Collins, Dep.
Register of Deeds
Register of Deeds Stamp & File Number

Section Corner, 29, 30, 31 & 32; T.46 N., R.43 W.

I, Richard L. Drahn in a field survey on April 20, 1999, do hereby certify that under requirements of P.A. 74, Michigan P.A. of 1970, the corner points mentioned in lines 1 and 2 above were in conformance with regulations and rules therefore as required in the current manual of survey instructions of the United States Department of the Interior, Bureau of Land Management or by a decree of a Court of Law and/or that the corner points mentioned in lines 3, 4 and 5 above were in conformance with the rules of the Michigan Board of Land Surveyors or by a Decree of a Court of Law; established, re-established, monumented, re-monumented, recovered, found as expressed below:

NOTE: Not more than 4 corners, all in the same town and range, may be recorded on this certificate.

	A	B	C	D	E	F	G	H	I	J	K	L	M
2	6	5	4	3	2	1							
3													
4	7	8	9	10	11	12							
5													
6	18	17	16	15	14	13							
7													
8	19	20	21	22	23	24							
9													
10	30	29	28	27	26	25							
11		●											
12	31	32	33	34	35	36							
13													

A. Description of original monument and accessories and/or subsequent restoration:

Corner established by Austin Burt on 8/26/1851. Original B.T.s ---Spruce 20" N.34 W. 17 links (11.22') --- Hemlock 12" S.57 E. 14 links (9.24') ---
Corner restored by Richard L. Drahn, RLS 21564 on 10/11/84 from the remains of the two original B.T.s and natural feature ties north and east. He set a 3/4" X 4' aluminum rod with a 3 1/4" stamped aluminum cap and the following new B.T.s --- 16" Yellow Birch N.81 W. 8.30' --- 6" Cedar N.38 E. 16.22' --- 11" Cedar S.15 E 11.96' --- 6' steel sign post N.43 W. 1.93' ---

Corner recorded in Gogebic County Liber 2, Page 633 on 12/10/84.

B. Description of corner evidence found and/or method applied in restoring or reestablishing corner:

Recovered the monument as described and the bearing trees as follows:

17"	Yellow Birch	N.81 W.	8.27'
7"	Cedar	N.38 E.	16.20'
13"	Cedar	S.15 E.	11.97'
6'	Steel sign rail	N.43 W.	1.93'

The identifiable remains of the original B.T.s are still present.


Corner research on file with Gogebic County records.

C. Description of monument for corner and accessories established to perpetuate locating the position of the corner:

New bearing tree referenced:

5" Cedar S.67 E. 14.41'

BEEN GROUP RECORDED
Richard L. Drahn 5/11/99
GOGEBIC COUNTY

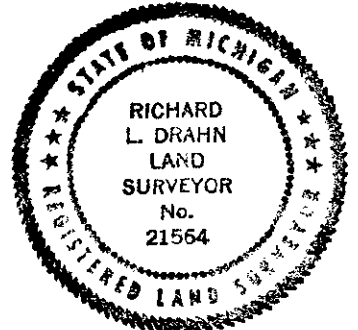

Signed by Richard L. Drahn Date April 21, 1999
Surveyor's Michigan License No. 21564