MAR 02 2000

SECTION

LAND CORNER RECORDATION CERTIFICATE

Filing Requirement of Act 74, Mich. P.A. 1970

Register's Office
Gogebic County } ss.

Received for record the 12TH day of MAY A. D. 1999 at 11:00 o'clock A m., and recorded in Liber 7 of CORNERS on page 102

Ramona Collins Deputy
Register of Deeds

Register of Deeds Stamp & File Number

For corners in Gogebic (County)

	Located In:	Corner Code #
1. Public Land Survey	T 46N R 43W	C-13
	T R	
	T R	
	T 45N R 43W	C-1
2. Property Controlling	S T R	
in Section	S T R	
3. Miscellaneous	S T R	
Property in Sec.	S T R	

4. Lot No. _____, Recorded Plat _____
5. Private Claims _____

Section Corner 31, 32, 5 & 6; T.45-46 N., R.43 W.

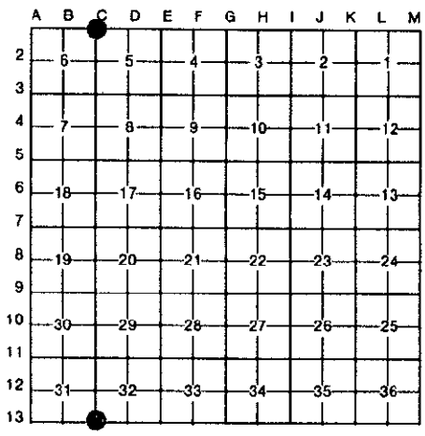

I, Richard L. Drahn in a field survey on April 20, 19 99, do hereby certify that under requirements of P.A. 74, Michigan P.A. of 1970, the corner points mentioned in lines 1 and 2 above were in conformance with regulations and rules therefore as required in the current manual of survey instructions of the United States Department of the Interior, Bureau of Land Management or by a decree of a Court of Law and/or that the corner points mentioned in lines 3, 4 and 5 above were in conformance with the rules of the Michigan Board of Land Surveyors or by a Decree of a Court of Law; established, re-established, monumented, re-monumented, recovered, found as expressed below:

NOTE: Not more than 4 corners, all in the same town and range, may be recorded on this certificate.

A. Description of original monument and accessories and/or subsequent restoration:

Corner established by Austin Burt 8/6/1847. Original B.T.s --- Spruce 12" N.32 E. 40 links (26.40') --- Fir 8" N.56 W. 6 links (3.96') --- Birch 10" S.25 W. 24 links (15.84') --- Balsam 7" S.45 E. 25 links (16.50') ---

Corner restored by Donald D. Lappala, RLS 12585 on 6/15/66 from the remains of the original Birch B.T. and natural features south and west. He set a 2" X 5' iron pipe with a 3" stamped brass cap and the following: --- 7" Cedar N66½ W. 13.8'--- Black Spruce 4" S.78 E. 40.0' ---White Spruce 7" S.23 W. 48.2' ---
Corner recorded in Gogebic County in USFS Liber, Page A-5 on 9/17/67.

B. Description of corner evidence found and/or method applied in restoring or reestablishing corner:

Recovered the monument as described and the bearing trees as follows:

7"	downed Cedar	N. 65 W.	----
5"	downed Black Spruce	S. 80 E.	----
12"	White Spruce	S. 27 W.	48.25'
	downed Cedar sign post	S. 23 W.	4.0'

B.T.s set by USFS on 3/18/92

7"	Cedar	N.07 E.	17.47'
8"	Black Spruce	N.78 E.	22.11'
6'	Steel sign rail	S.31 W.	1.15'

Very badly decayed Yellow Birch stump at S.25 W. 15.8' is still evident.

Corner research on file with Gogebic County records.

C. Description of monument for corner and accessories established to perpetuate locating the position of the corner:

New bearing tree referenced:

4"	Red Maple	S.47 E.	15.72'

PEER GROUP APPROVED
Richard L. Drahn 5/11/99
COUNTY REPRESENTATIVE

STATE OF MICHIGAN
RICHARD L. DRAHN
LAND SURVEYOR
No. 21564
REGISTERED LAND SURVEYOR

Signed by Richard L. Drahn Date April 21, 1999

Surveyor's Michigan License No. 21564

USFS Z-5

102

FORM APPROVED BY MICHIGAN STATE BOARD OF LAND SURVEYORS, JAN. 28, 1971
REVISED MAY 14, 1975
REVISED JAN., 1983