

SURVEY &  
REMONUMENTATION

SEP 08 1998

SECTION

LAND CORNER RECORDATION CERTIFICATE  
Filing Requirement of Act 74, Mich. P.A. 1970

For corners in

<u>Gogebic</u> (County)	Located In:	Corner Code #
1. Public Land Survey	<u>T46N R43W</u>	<u>D-5</u>
	T ___ R ___	___
	T ___ R ___	___
	T ___ R ___	___
2. Property Controlling in Section	S ___ T ___ R ___	___
	S ___ T ___ R ___	___
3. Miscellaneous Property in Sec.	S ___ T ___ R ___	___
	S ___ T ___ R ___	___

Register's Office }  
Gogebic County } ss.

Received for record the  
14<sup>TH</sup> day of MAY  
A. D. 1998 at 3:00 o'clock  
P m., and recorded in  
Liber 6 of CORNERS  
on page 337  
Barbara Collins Deputy  
Register of Deeds

Register of Deeds Stamp & File Number

4. Lot No. \_\_\_\_\_, Recorded Plat \_\_\_\_\_  
5. Private Claims \_\_\_\_\_

1/4 corner comm. to sec's. 8 & 17, T46N, R43W

I, John P. Goss, in a field survey on May 4, 1998 do hereby state that under requirements of P.A. 74, Michigan P.A. of 1970, the corner points mentioned in lines 1 and 2 above were in conformance with regulations and rules therefore as required in the current manual of survey instructions of the United States Department of the Interior, Bureau of Land Management or by a decree of a Court of Law and/or that the corner points mentioned in lines 3, 4 and 5 above were in conformance with the rules of the Michigan Board of Land Surveyors or by a Decree of a Court of Law; established, re-established, monumented, recovered, found as expressed below:

A	B	C	D	E	F	G	H	I	J	K	L	M
1												
2	6		5		4		3		2		1	
3												
4	7		8		9		10		11		12	
5												
6	18		17		16		15		14		13	
7												
8	19		20		21		22		23		24	
9												
10	30		29		28		27		26		25	
11												
12	31		32		33		34		35		36	
13												

NOTE: Not more than 2 corners, all in the same town and range, may be recorded on this certificate.

A. Description of original monument and accessories and/or subsequent restoration:

Corner established by Austin Burt, on September 8, 1851.  
Original bearing trees: Y. Birch 16" S 20° E 14 links (9.24 feet)  
Y. Birch 10" N 04° W 11 links (7.26 feet)  
Ewart C. Muller, RLS, monument this corner on Aug. 19, 1976 by occupational lines  
He recorded in Liber 1, page 193 of LCGC.  
Richard Drahn, RLS, restored corner position from remains of the two original  
bearing trees, on May 24, 1984. He set a 2 1/2" I.D. iron pipe with 3" brass cap  
stamped to indicated the corner position; He established the following reference  
objects: 6" Red Maple - N 78° W - 27.78 feet;

B. Description of corner evidence found and/or method applied in restoring or reestablishing corner:

18" Cedar - N 22° E - 21.97 feet  
17" Hemlock - S 69° E - 7.86 feet.  
6' steel sign post - N 45° W - 2.4 feet. He recorded said corner in Liber 2,  
page 591 of Land Corner for Gogebic County.

Found Richard L. Drahn, monument and witnesses.

I updated the corner monument and accessories as noted below to state and  
county specification.

Act 74 research on file.

PEER GROUP APPROVED


Richard L. Drahn 5/13/98  
COUNTY REGISTER

C. Description of monument for corner and accessories established to perpetuate locating the position of the corner:

From the found 2 1/2" iron pipe with 3" brass cap which reads: T.46 N., R.43 W.;  
1/4; S-8, S-17; 1984; R.L.S. 21564: from which I established the following  
existing and new reference objects:

19" Red Maple	N 78° W	27.78 feet
22" Hemlock	S 69° E	7.86 feet
21" Cedar	N 22° E	21.97 feet
6' steel sign post	N 45° W	2.4 feet (to face)
5" Maple	S 69° W	24.15 feet

( All dimensions are to nail in side of tree)

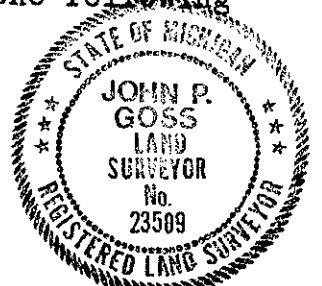

Signed by John P. Goss  
Surveyor's Michigan License No. 23509

Date May 4, 1998

Fed. No. J-7