

**SURVEY &
REMONUMENTATION**

SEP 08 1998

SECTION

LAND CORNER RECORDATION CERTIFICATE
Filing Requirement of Act 74, Mich. P.A. 1970

For corners in

<u>Gogebic</u> (County)	Located In:	Corner Code #
1. Public Land Survey	T46NR 43W	D-7
	T ___ R ___	___
	T ___ R ___	___
	T ___ R ___	___
2. Property Controlling in Section	S ___ T ___ R ___	___
	S ___ T ___ R ___	___
3. Miscellaneous Property in Sec.	S ___ T ___ R ___	___
	S ___ T ___ R ___	___

Register's Office }
Gogebic County } ss.

Received for record the
14TH day of MAY
A. D. 1998 at 3:00 o'clock
P m., and recorded in
Liber 6 of CORNERS
on page 338
Ramona Collins Deputy
Register of Deeds

Register of Deeds Stamp & File Number

4. Lot No. _____, Recorded Plat _____
5. Private Claims _____

1/4 corner common to sec's. 17 & 20, T46N, R43W

I, John P. Goss, in a field survey on May 6, 1998 do hereby state that under requirements of P.A. 74, Michigan P.A. of 1970, the corner points mentioned in lines 1 and 2 above were in conformance with regulations and rules therefore as required in the current manual of survey instructions of the United States Department of the Interior, Bureau of Land Management or by a decree of a Court of Law and /or that the corner points mentioned in lines 3, 4 and 5 above were in conformance with the rules of the Michigan Board of Land Surveyors or by a Decree of a Court of Law; established, re-established, monumented, recovered, found as expressed below:

NOTE: Not more than 2 corners, all in the same town and range, may be recorded on this certificate.

A	B	C	D	E	F	G	H	I	J	K	L	M
1												
2	6		5		4		3		2		1	
3												
4	7		8		9		10		11		12	
5												
6	18		17		16		15		14		13	
7												
8	19		20		21		22		23		24	
9												
10	30		29		28		27		26		25	
11												
12	31		32		33		34		35		36	
13												

A. Description of original monument and accessories and/or subsequent restoration:

Corner established by Austin Burt, on July 17, 1851.

Original bearing trees: Lynn S 40° W 12 links (7.92')
Yellow Birch N 14° E 05 links (3.30')

Richard L. Drahn, RLS, on October 2, 1984, restored corner position at record bearing and distance from the original yellow birch bearing tree. He set a 2" I.D. by 30" aluminum monument with 3/4" aluminum cap, stamped to indicate the corner position. He established the following reference objects.

11" Sugar Maple N 08° W 19.69' (out) 5" Sugar Maple S 71° W 21.10'
7" Sugar Maple S 45° E 6.38' (out) 6' steel sign post S 43° W 2.75'

B. Description of corner evidence found and/or method applied in restoring or reestablishing corner:

He recorded said corner in Liber 2 page 635 of Land Corners for Gogebic County.

Found Richard L. Drahn corner monument and one witness plus snow fence rail N 53° E and 0.3 feet from corner position.

I updated the corner monument and accessories as noted below to state and county specification.

Act 74 research on file.


PEER GROUP APPROVED
Richard L. Drahn 5/13/98
COURT RECORDED

C. Description of monument for corner and accessories established to perpetuate locating the position of the corner:

From the 2" I.D. aluminum monument and 3/4" aluminum cap which reads: T.46 N., R.43 W.; 1/4; S-17, S-20; 1984; R.L.S. 21564: from which I established the following existing and new reference objects:

7" Maple S 71° W 21.10'
9" Maple N 01° W 68.07'
P.Pole #20-52/91 S 73° E 38.28'
6' steel sign post S 43° W 2.75' (to face)
Snow fence Rail N 53° E 0.3' (to face)

(All distance to nail in side of tree or P.Pole)

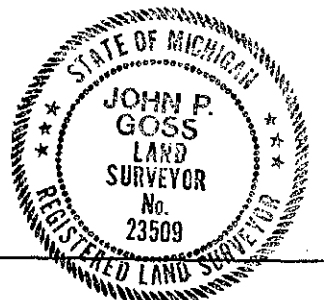

Signed by John P. Goss
Surveyor's Michigan License No. 23509

Date May 6, 1998

Fed. No. N-7