

**SURVEY &
REMONUMENTATION**

SEP 08 1998

SECTION

LAND CORNER RECORDATION CERTIFICATE
Filing Requirement of Act 74, Mich. P.A. 1970

For corners in

<u>Gogebic</u> (County)	Located In:	Corner Code #
1. Public Land Survey	T46N R43W	E-4
	T___ R___	_____
	T___ R___	_____
	T___ R___	_____
2. Property Controlling in Section	S___ T___ R___	_____
	S___ T___ R___	_____
3. Miscellaneous Property in Sec.	S___ T___ R___	_____
	S___ T___ R___	_____

Register's Office }
Gogebic County } ss.

Received for record the
14th day of MAY
A. D. 1998 at 3:00 o'clock
P m., and recorded in
Liber 6 of CORNERS
on page 341
Ramona Collins, Deputy
Register of Deeds

Register of Deeds Stamp & File Number

4. Lot No. _____, Recorded Plat _____
5. Private Claims _____

1/4 corner common to sec's. 8 & 9, T46N, R43W

I, John P. Goss, in a field survey on May 1, 1998 do hereby state that under requirements of P.A. 74, Michigan P.A. of 1970, the corner points mentioned in lines 1 and 2 above were in conformance with regulations and rules therefore as required in the current manual of survey instructions of the United States Department of the Interior, Bureau of Land Management or by a decree of a Court of Law and/or that the corner points mentioned in lines 3, 4 and 5 above were in conformance with the rules of the Michigan Board of Land Surveyors or by a Decree of a Court of Law; established, re-established, monumented, recovered, found as expressed below:

NOTE: Not more than 2 corners, all in the same town and range, may be recorded on this certificate.

1	A	B	C	D	E	F	G	H	I	J	K	L	M
2		6		5		4		3		2		1	
3													
4		7		8		9		10		11		12	
5													
6		18		17		16		15		14		13	
7													
8		19		20		21		22		23		24	
9													
10		30		29		28		27		26		25	
11													
12		31		32		33		34		35		36	
13													

A. Description of original monument and accessories and/or subsequent restoration:

Corner established by Austin Burt, on August 28, 1851.
Original bearing trees: Sugar 12" S 38° E 43 links (28.38')
Sugar 8" N 62° W 54 links (35.64')

Richard L. Drahn, RLS, restored this corner position at record bearing and distance from the remains of the two original bearing trees. He set a 2" I.D. by 30" aluminum monument with 3/4" aluminum cap stamped to indicated corner position. He established following bearing trees: Restored on June 12, 1984.

11" Red Maple N 01° E 6.42' (stump only now)
6" Sugar Maple S 24° W 9.21'

B. Description of corner evidence found and/or method applied in restoring or reestablishing corner:

6" Sugar Maple S 85° W 14.38'
6' Steel sign post S 84° W 2.6'

He recorded said corner in Liber 2, page 605 of Land Corners for Gogebic County

Found Richard L. Drahn corner monument and witnesses.

I updated the corner monument and accessories as noted below to state and county specification.


Act 74 research on file.

PEER GROUP APPROVED
Richard L. Drahn 5/13/98
COUNTY BOARD OF SURVEYORS

C. Description of monument for corner and accessories established to perpetuate locating the position of the corner:
From the 2" I.D. aluminum monument with 3/4" aluminum cap stamped to read: T.46 N., R.43 W.; 1/4; S-8, S-9; 1984.; R.L.S. 21564; from which I established the existing and new reference objects.

10" Sugar Maple S 24° W 9.21'
10" Sugar Maple S 85° W 14.38'
11" Sugar Maple N 66° E 28.00'
8" Sugar Maple S 09° E 12.37'
6' Steel Post & sign S 84° W 2.6' (to face)

(All measurement are to nail in side of tree)

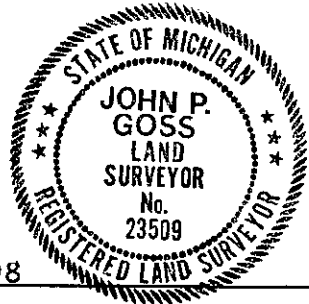

Signed by John P. Goss
Surveyor's Michigan License No. 23509

Date May 2, 1998

Fed. No. G-9