

SURVEY &
REMONUMENTATION

SEP 08 1998

LAND CORNER RECORDATION CERTIFICATE
Filing Requirement of Act 74, Mich. P.A. 1970

Register's Office } ss.
Gogebic County }

For corners in SECTION

<u>Gogebic</u> (County)	Located In:	Corner Code #
1. Public Land Survey	T <u>46</u> N R <u>43</u> W	E-6
	T ___ R ___	_____
	T ___ R ___	_____
	T ___ R ___	_____
2. Property Controlling in Section	S ___ T ___ R ___	_____
	S ___ T ___ R ___	_____
3. Miscellaneous Property in Sec.	S ___ T ___ R ___	_____
	S ___ T ___ R ___	_____

Received for record the
14th day of MAY
A. D. 1998 at 3:00 o'clock
P m., and recorded in
Liber 6 of CORNERS
on page 343
Ramona Collins Deputy
Register of Deeds

Register of Deeds Stamp & File Number

4. Lot No. _____, Recorded Plat _____
5. Private Claims _____

1/4 corner comm. to sec's 16 & 17, T46N, R43W

I, John P. Goss, in a field survey on May 4, 1998 do hereby state that under requirements of P.A. 74, Michigan P.A. of 1970, the corner points mentioned in lines 1 and 2 above were in conformance with regulations and rules therefore as required in the current manual of survey instructions of the United States Department of the Interior, Bureau of Land Management or by a decree of a Court of Law and /or that the corner points mentioned in lines 3, 4 and 5 above were in conformance with the rules of the Michigan Board of Land Surveyors or by a Decree of a Court of Law; established, re-established, monumented, recovered, found as expressed below:

A	B	C	D	E	F	G	H	I	J	K	L	M
1												
2	6		5		4		3		2		1	
3												
4	7		8		9		10		11		12	
5												
6	18		17		16		15		14		13	
7												
8	19		20		21		22		23		24	
9												
10	30		29		28		27		26		25	
11												
12	31		32		33		34		35		36	
13												

NOTE: Not more than 2 corners, all in the same town and range, may be recorded on this certificate.

A. Description of original monument and accessories and/or subsequent restoration:

Original corner established by Austin Burt on August 28, 1851.
Original bearing trees: Sugar 14" S 57° W 29 links (19.14')
Sugar 10" N 24° E 15 links (9.90')

Richard L. Drahn, RLS, restored this corner position, by "tying in" numerous lot corners and occupational lines within the Village of Marenisco Plat of 1886 & 1887. He set a 2" I.D. iron pipe with 3" brass cap stamped to indicated the corner position. He established the following reference objects:
5" Pine N 37° E 53.07' 6' metal sign post N 78° E 1.9'
6" Aspen S 34° E 43.63' (stump only now) Restored on May 16, 1985.

B. Description of corner evidence found and/or method applied in restoring or reestablishing corner:

Found Richard L. Drahn monument and witnesses, which he had recorded in Liber 2 page 729 of Land Corners for Gogebic County,

I updated the corner monument and accessories as noted below to state and county specification.

Act 74 research on file.

PEER GROUP APPROVED
Richard L. Drahn 5/13/98
COUNTY REGISTER

C. Description of monument for corner and accessories established to perpetuate locating the position of the corner:


From the found 2" I.D. iron pipe with 3" brass cap which reads: T.46 N., R.43 W.: 1/4; S-16, S-17; 1985; R.L.S. 21564. From which I established the following existing and new reference objects:

10" Pine	N 37° E	53.07 feet	
9" Aspen	N 17° W	77.38 feet	
4" Spruce	Due West	82.74 feet	
6' metal sign post	N 78° E	1.9 feet	(to face)

(All measurement to nail in side of tree)

Signed by John P Goss
Surveyor's Michigan License No. 23509

Date May 4, 1998

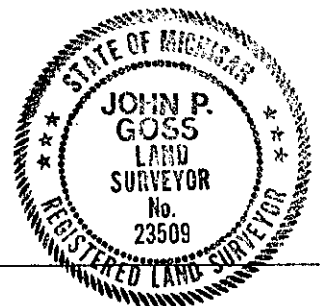

Fed. No. L-9