

SURVEY & REMONUMENTATION

OCT 03 1995

COMMISSION

LAND CORNER RECORDATION CERTIFICATE
Filing Requirement of Act 74, Mich. P.A. 1970

For corners in Gogebic (County)	Located In:	Corner Code #
1. Public Land Survey	T 46N R 43W T _____ T _____ T _____	E-7 _____ _____ _____
2. Property Controlling in Section	S _____ T _____ R _____ S _____ T _____ R _____	_____ _____ _____
3. Miscellaneous Property in Section	S _____ T _____ R _____ S _____ T _____ R _____	_____ _____ _____
4. Lot No. _____, Recorded Plat _____		
5. Private Claims _____		


Register's Office }
 Gogebic County } ss.

Received for record the
23RD day of FEB
 A. D. 1996 at 1:35 o'clock
P m., and recorded in
 Liber 5 of CORNERS
 on page 314
Ramona Collins, Deputy
 Register of Deeds

Register of Deeds Stamp & File Number

Section corner common to Sections 16, 17, 20 and 21, T46N, R43W.

I, John R. Garske, in a field survey on November 9, 19 95, do hereby certify that under requirements of P.A. 74, Michigan P.A. of 1970, the corner points mentioned in lines 1 and 2 above were in conformance with regulations and rules therefore as required in the current manual of survey instructions of the United States Department of the Interior, Bureau of Land Management or by a decree of a Court of Law and/or that the corner points mentioned in lines 3, 4 and 5 above were in conformance with the rules of the Michigan Board of Professional Surveyors or by a Decree of a Court of Law; established, re-established, monumented, re-monumented, recovered, found as expressed below:

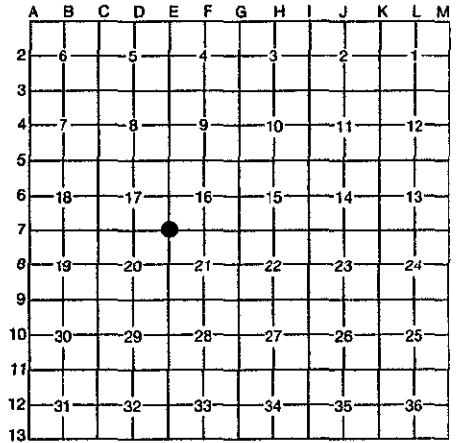

NOTE: Not more than 4 corners, all in the same town and range, may be recorded on this certificate.

A. Description of original monument and accessories and/or subsequent restoration:

- On July 17, 1851, Austin Burt, U.S.D.S., set the corner post from which bears a: 12" spruce - S16°W - 32 links; 6" cedar - N52°E - 33 links.
- On January 28, 1985, U.S.F.S. Surveyor Richard L. Drahn, RLS 21564, found a 7/8" iron rod in a Michigan highway monumentation box which replaced a 4" concrete monument set in 1939. This corner has been called on and since 1930 on Town Plats of Marenisco. From the monument Drahn set the following reference objects:

3/4" rebar in conc. cylinder 6" below ground - 34°E - 59.95 feet	P. Pole - N44°E - 38.38 feet
3/8" rebar in conc. cylinder 6" below ground - S57°E - 60.09 feet	Sign post - S53°W - 43.34 feet

Corner recorded in Liber 2 of land corners Page 720.

B. Description of corner evidence found and/or method applied in restoring or reestablishing corner:

I found the monument and accessories set by Drahn as described above.

Act 74 research on file at County Register of Deeds office. (SEE SKETCH ON BACK)

PEER GROUP APPROVED
Richard L. Drahn 12/14/95
 COUNTY REPRESENTATIVE



C. Description of monument for corner and accessories established to perpetuate locating the position of the corner:

I used the monument described above at the corner location and established the following reference objects:

- 5/8" rebar in concrete cylinder 6" below ground - S34°E - 59.90 feet
- 3/4" rebar in concrete cylinder 6" below ground - S57°E - 60.06 feet
- P. Pole - N44°E - 38.38 feet

I also set two 2" I.D. x 30" aluminum reference monuments with 3 1/4" aluminum caps stamped to read: T46N, R43W, R.M., S-16, S-17, S-20, S-21, N30°W - 45.00 feet, 1995, RLS 28410, with 6' steel sign post 1.28 feet away and T46N, R43W, R.M., S-16, S-17, S-20, S-21 - S50°W - 42.00 feet, 1995, RLS 28410, with 6' steel sign post 1.23 feet away.

Signed by John R. Garske Date 12-11-95
 Surveyor's Michigan License No. 28410

SURVEY &
REMONUMENTATION

OCT 03 1996

COMMISSION

SKETCH

BEARINGS ARE
MAGNETIC

SEC. COR.

17 | 16
20 | 21

T46N, R43W

FOUND MDOT
MONUMENT BOX

