

SURVEY & DOCUMENTATION

OCT 03 1996

COMMISSION

LAND CORNER RECORDATION CERTIFICATE
Filing Requirement of Act 74, Mich. P.A. 1970

For corners in <u>Gogebic</u> (County)	Located In:	Corner Code #
1. Public Land Survey	T <u>46N</u> R <u>43W</u>	<u>E-9</u>
	T _____ R _____	_____
	T _____ R _____	_____
	T _____ R _____	_____
2. Property Controlling in Section	S _____ T _____ R _____	_____
	S _____ T _____ R _____	_____
3. Miscellaneous	S _____ T _____ R _____	_____
Property in Section	S _____ T _____ R _____	_____

Register's Office }
 Gogebic County } ss.


Received for record the
16th day of AUGUST
 A. D. 1996...at 10:45 o'clock
A m., and recorded in
 Liber 6 of CORNERS
 on page 3
Ramona Collins Deputy
 Register of Deeds

Register of Deeds Stamp & File Number

4. Lot No. _____, Recorded Plat _____
 5. Private Claims _____

The section corner common to 20, 21, 28 and 29, T46N-R43W.

I, John R. Garske, in a field survey on August 13, 1996, do hereby certify that under requirements of P.A. 74, Michigan P.A. of 1970, the corner points mentioned in lines 1 and 2 above were in conformance with regulations and rules therefore as required in the current manual of survey instructions of the United States Department of the Interior, Bureau of Land Management or by a decree of a Court of Law and/or that the corner points mentioned in lines 3, 4 and 5 above were in conformance with the rules of the Michigan Board of Professional Surveyors or by a Decree of a Court of Law; established, re-established, monumented, re-monumented, recovered, found as expressed below:

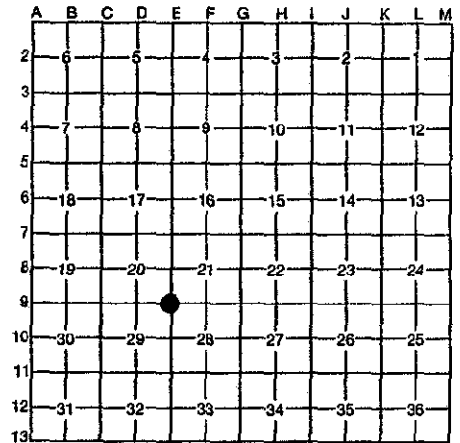

NOTE: Not more than 4 corners, all in the same town and range, may be recorded on this certificate.

A. Description of original monument and accessories and/or subsequent restoration:

On August 27, 1851, Austin Burt, U.S. Deputy Surveyor, established the corner and the following bearing trees:
 8" sugar - S41°E - 14 links
 34" Y. birch - N12°W - 12 links

In 1986, Richard Drahn re-established and recorded the corner on Liber 2 pg. 730 of land corners. The following bearing trees were established:

- 17" Yellow birch - N71°E - 32.71 feet
- 9" Red maple - S14°E - 20.96 feet
- 13" Balsam - S69°W - 10.07 feet
- Steel sign post - N02°W - 2.2 feet

B. Description of corner evidence found and/or method applied in restoring or reestablishing corner:

I found the monument and bearing trees set by Richard Drahn and accepted it as correct. The bearing trees and brass monument were in good condition. I updated the bearing trees and established one more bearing tree. See below.

P.A. 74 research on file.


C. Description of monument for corner and accessories established to perpetuate locating the position of the corner:

The following bearing trees and reference objects were newly painted and updated. One bearing tree was established:

- 17" Yellow birch - N71°E - 32.71 feet (existing)
- 9" Red maple - S14°E - 20.96 feet (existing)
- 13" Balsam - S69°W - 10.07 feet (existing)
- 6" Sugar - N48°W - 38.92 feet (new)
- Steel Sign Rail - N02°W - 2.2 feet (existing)

PEER GROUP APPROVED

Richard B. Neelan 8/14/96
 COUNTY REPRESENTATIVE

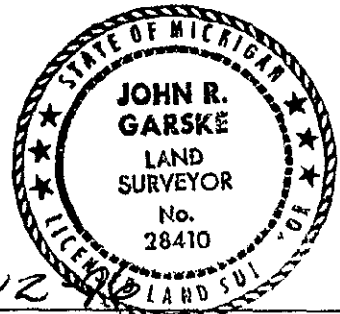

Signed by John R. Garske
 Surveyor's Michigan License No. 28410

Date 8-12-96