

DEC 15 1998

SECTION

LAND CORNER RECORDATION CERTIFICATE  
Filing Requirement of Act 74, Mich. P.A. 1970

For corners in

Gogebic

(County)

Located In:

Corner Code #

- |                                    |                           |     |
|------------------------------------|---------------------------|-----|
| 1. Public Land Survey              | T <u>46N</u> R <u>43W</u> | F-3 |
|                                    | T ___ R ___               | ___ |
|                                    | T ___ R ___               | ___ |
|                                    | T ___ R ___               | ___ |
| 2. Property Controlling in Section | S ___ T ___ R ___         | ___ |
|                                    | S ___ T ___ R ___         | ___ |
| 3. Miscellaneous Property in Sec.  | S ___ T ___ R ___         | ___ |
|                                    | S ___ T ___ R ___         | ___ |

Register's Office }  
Gogebic County } ss.


Received for record the  
30<sup>TH</sup> day of OCTOBER  
A. D. 1998 at 9:05 o'clock  
A m., and recorded in  
Liber 7 of CORNERS  
on page 61  
Ramona Collins Deputy  
Register of Deeds

Register of Deeds Stamp & File Number

4. Lot No. \_\_\_\_\_, Recorded Plat \_\_\_\_\_  
5. Private Claims \_\_\_\_\_

1/4 corner 4 & 9, T46N, R43W

I, John P. GOSS, in a field survey on Oct. 15, 1998 do hereby state that under requirements of P.A. 74, Michigan P.A. of 1970, the corner points mentioned in lines 1 and 2 above were in conformance with regulations and rules therefore as required in the current manual of survey instructions of the United States Department of the Interior, Bureau of Land Management or by a decree of a Court of Law and/or that the corner points mentioned in lines 3, 4 and 5 above were in conformance with the rules of the Michigan Board of Land Surveyors or by a Decree of a Court of Law; established, re-established, monumented, recovered, found as expressed below.

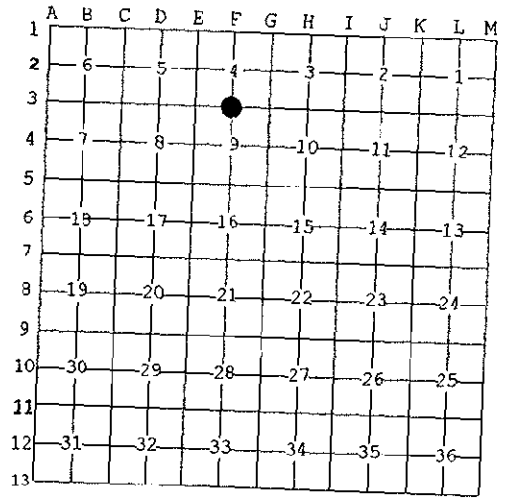

NOTE: Not more than 2 corners, all in the same town and range, may be recorded on this certificate.

A. Description of original monument and accessories and/or subsequent restoration:  
Original corner established by Austin Burt, U.S. Deputy Surveyor on Sept. 6, 1881  
Original bearing trees: Spruce 10" S 40° E 41 links (27.06')  
Fir 10" N 55° W 41 links (27.06')

On June 16, 1986, Richard L. Drahn, RLS, USFS, restored corner position by retracement measurement from the re-established centerline of 1917 railroad plans and natural feature ties east & west to the Presque Isle River. He set a 2" I.D. pipe with 3" circular brass tablet which reads: T46N-R43W; 1/4; S-9, S-4; 1986; R.L.S. 21564. He established the following reference objects:  
6" Black Ash - N 04° W - 41.14'; 16" Cedar (Now stub) - S 87° E - 38.12'

B. Description of corner evidence found and/or method applied in restoring or reestablishing corner:  
Steel sign post - S 03° W - 3.71'; Steel sign post - S 86° W - 1.67'  
He recorded said corner in Liber 3 of Land Corners for Gogebic County, Page 4.  
Found Richard L. Drahn monument and accessories.

I updated the monument and accessories as noted below to state and county specification.

Act 74 research on file.

PEER GROUP APPROVED  
Richard L. Drahn 10/27/98  
COUNTY REGISTER

C. Description of monument for corner and accessories established to perpetuate locating the position of the corner:  
From the found monument I established the following existing and new reference objects:

- |                 |         |                 |
|-----------------|---------|-----------------|
| 8" Black Ash    | N 04° W | 41.24' new nail |
| 18" Cedar       | S 88° E | 42.88' new nail |
| Steel sign post | S 03° W | 3.71'           |
| Steel sign post | S 86° W | 1.67'           |



Signed by John P. Goss  
Surveyor's Michigan License No. 23509

Date October 15, 1998

U.S.F.S. No. E-11