

SURVEY & REMONUMENTATION

SEP 08 1998

LAND CORNER RECORDATION CERTIFICATE Register's Office } ss.
 Filing Requirement of Act 74, Mich. P.A. 1970 } Gogebic County }

SECTION

For corners in

Gogebic
(County)

Located In:

Corner Code #

1. Public Land Survey

T46N R43W F-5
 T___ R___
 T___ R___
 T___ R___

2. Property Controlling in Section

S___ T___ R___
 S___ T___ R___

3. Miscellaneous Property in Sec.

S___ T___ R___
 S___ T___ R___

4. Lot No. _____, Recorded Plat _____

5. Private Claims _____


1/4 corner, Sections 9 & 16, T46N, R43W

I, John P. Goss, in a field survey on May 7, 1998 do hereby state that under requirements of P.A. 74, Michigan P.A. of 1970, the corner points mentioned in lines 1 and 2 above were in conformance with regulations and rules therefore as required in the current manual of survey instructions of the United States Department of the Interior, Bureau of Land Management or by a decree of a Court of Law and/or that the corner points mentioned in lines 3, 4 and 5 above were in conformance with the rules of the Michigan Board of Land Surveyors or by a Decree of a Court of Law; established, re-established, monumented, recovered, found as expressed below.

NOTE: Not more than 2 corners, all in the same town and range, may be recorded on this certificate.

Received for record the
14th day of MAY
 A. D. 1998 at 3:10 o'clock
P m., and recorded in
 Liber 6 of CORNERS
 on page 344
Ramona Collins, Deputy
 Register of Deeds

Register of Deeds Stamp & File Number

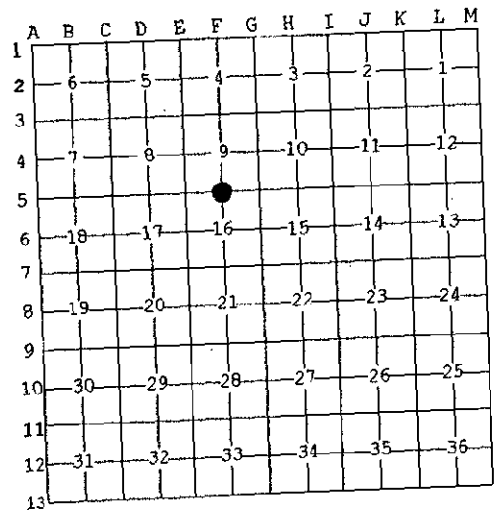

A. Description of original monument and accessories and/or subsequent restoration:

Corner established by Austin Burt, on September 8, 1851.

Original bearing trees: Cedar 12" S 07° W 28 links (18.48')
 Cedar 10" N 17° E 5 links (3.30')

Richard L. Drahn, RLS, on August 21, 1985, restored corner position at record bearing and distances from the remains of the two original bearing tree. He set a 3/4" diameter by 4' long aluminum rod monument with a 3/4" aluminum cap stamped to indicated the corner position. He established the following reference objects:

7" Black Ash N 06° W 30.64' 13" Black Ash S 45° E 7.84'

B. Description of corner evidence found and/or method applied in restoring or reestablishing corner:

11" Black Ash S 87° W 36.34' 6' steel sign post N 10° W 1.9'

He recorded said corner in Liber 2, page 731 of Land Corners for Gogebic County

Found Richard L. Drahn corner monument and witnesses.

I updated the corner monument and accessories as noted below to state and county specification.

Act 74 research on file.


PEER GROUP APPROVAL
Richard L. Drahn 5/13/98
 COUNTY REGISTER

C. Description of monument for corner and accessories established to perpetuate locating the position of the corner:

From the 3/4" dia. by 4' long aluminum monument with 3/4" aluminum cap which reads: T.46 N., R.43 W.: 1/4; S-9, S-16; 1985; R.L.S. 21564; from which I established the existing and new reference objects:

9" Black Ash N 06° W 30.60'
 15" Black Ash S 45° E 7.84'
 13" Black Ash S 87° W 36.30'
 9" Black Ash N 26° E 24.79'
 6' Steel sign post N 10° W 1.9' (to face)

(All measurements are to nail in side of tree)

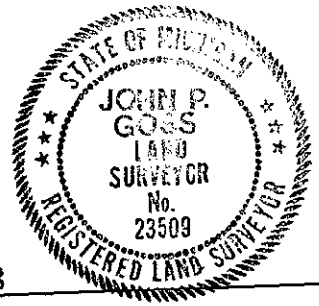

Signed by John P. Goss
 Surveyor's Michigan License No. 23509

Date May 7, 1998

Fed. No. J-11