

DEC 15 1998

SECTION

LAND CORNER RECORDATION CERTIFICATE  
Filing Requirement of Act 74, Mich. P.A. 1970

Register's Office }  
Gogebic County } ss.

For corners in

Gogebic  
(County)

Located in:

Corner Code #

- |                                    |                             |            |
|------------------------------------|-----------------------------|------------|
| 1. Public Land Survey              | T <u>46</u> N R <u>43</u> W | <u>G-3</u> |
|                                    | T ___ R ___                 | ___        |
|                                    | T ___ R ___                 | ___        |
|                                    | T ___ R ___                 | ___        |
| 2. Property Controlling in Section | S ___ T ___ R ___           | ___        |
|                                    | S ___ T ___ R ___           | ___        |
| 3. Miscellaneous Property in Sec.  | S ___ T ___ R ___           | ___        |
|                                    | S ___ T ___ R ___           | ___        |

Received for record the  
30<sup>TH</sup> day of OCTOBER  
A. D. 1998 at 9:05 o'clock  
A m., and recorded in  
Liber 7 of CORNERS  
page 62  
Ramona Collins Deputy  
Register of Deeds


Register of Deeds Stamp & File Number

4. Lot No. \_\_\_\_\_, Recorded Plat \_\_\_\_\_  
5. Private Claims \_\_\_\_\_

Section Corner 3, 4, 9 & 10, T46N, R43W

I, John P. Goss, in a field survey on Oct. 26, 1998 do hereby state that under requirements of P.A. 74, Michigan P.A. of 1970, the corner points mentioned in lines 1 and 2 above were in conformance with regulations and rules therefore as required in the current manual of survey instructions of the United States Department of the Interior, Bureau of Land Management or by a decree of a Court of Law and/or that the corner points mentioned in lines 3, 4 and 5 above were in conformance with the rules of the Michigan Board of Land Surveyors or by a Decree of a Court of Law; established, re-established, monumented, recovered, found as expressed below:

NOTE: Not more than 2 corners, all in the same town and range, may be recorded on this certificate.

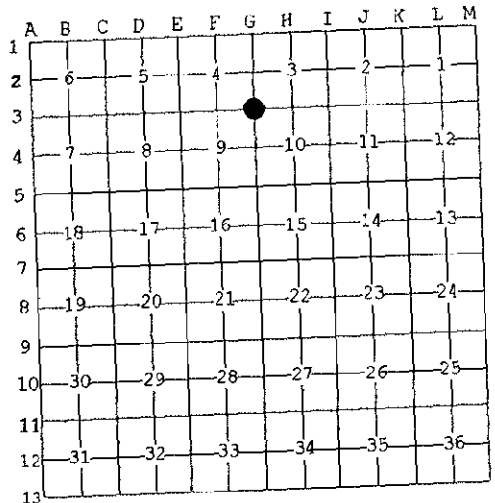

A. Description of original monument and accessories and/or subsequent restoration:  
Original corner established by Austin Burt, U.S. Deputy Survey on Aug. 30, 1851.  
Original bearing trees: Spruce 14" S 40° W 25 links (16.50')  
Y. Birch 8" N 05° E 29 links (19.14')

On June 16, 1986, Richard L. Drahn, RLS, USFS, restored corner position at record bearing and distance from the stump holes of the two original bearing trees. He set a 2" I.D. Iron pipe with 3" circular brass tablet which reads: T.46 N., R.43 W.; S-3, S-4, S-9, S-10; 1986; R.L.S. 21564. From which he established the following reference objects: 5" Y. Birch-N 64° W - 31.74'; 11" Cedar-S 63° E - 24.27'; 6" S. Maple - S 08° W - 32.53'; 6' steel sign

B. Description of corner evidence found and/or method applied in restoring or reestablishing corner:  
post - N 12° E - 1.4'  
He recorded said corner in Liber 3, page 10 of Land corners for Gogebic County.

Found Richard L. Drahn monument and reference objects.

I updated the monument and accessories as noted below to state and county specification.

Act 74 research on file.

PEER GROUP APPROVED  
Richard L. Drahn 10/27/98  
COUNTY REGISTER

C. Description of monument for corner and accessories established to perpetuate locating the position of the corner:  
From the found monument I established the following existing and new reference objects:

- |                    |         |        |          |
|--------------------|---------|--------|----------|
| 7" Yellow Birch    | N 64° W | 31.74' |          |
| 12" Cedar          | S 63° E | 24.15' | new nail |
| 7" Sugar Maple     | S 08° W | 32.55' |          |
| 6" Tw. Maple       | N 58° E | 6.85'  |          |
| 6' steel sign post | N 12° E | 1.39'  | to face  |



Signed by John P. Goss  
Surveyor's Michigan License No. 23509  
U.S.F.S. No. E-13

Date October 26, 1998